


7:03:37 AM Q:\2015 Projects\15-030.02 Donner Pass Preliminary Design - CFLHD\CA FLAP NEV 40(1)Roadway\CAADO_Sheets\A-Gen_shr\TTL(DONN)CA40.dgn User: mcarlson

STATE	PROJECT	SHEET NUMBER
CA	CA FLAP NEV 40(1) DONNER PASS	A1

U.S. DEPARTMENT OF TRANSPORTATION FEDERAL HIGHWAY ADMINISTRATION

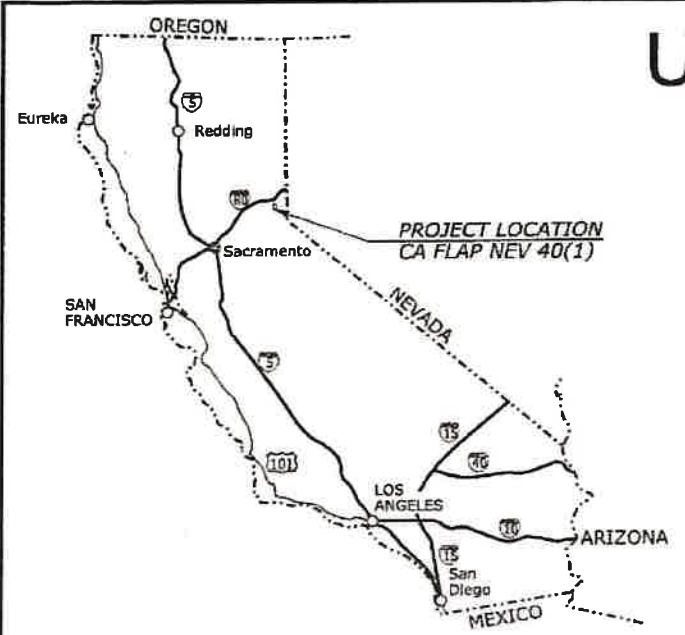

KEY MAP OF CALIFORNIA

PLANS FOR PROPOSED CA FLAP NEV 40(1) DONNER PASS ROAD TAHOE NATIONAL FOREST NEVADA COUNTY, CA PLACER COUNTY, CA LENGTH 6.40 miles


AS-BUILT DRAWINGS

TYPE OF CONSTRUCTION:
Restoration, Resurfacing, and Rehabilitation (3R+)
(Widening, Grading, Drainage and Asphalt Concrete Pavement)

DESIGN DESIGNATIONS:
ADT (2020) ----- 1902
ADT (2040) ----- 2321
DHV ----- 8
D ----- 50%
T ----- 2%
V ----- 35 mph
e(max) ----- 8%

U.S. CUSTOMARY DIMENSIONS:
Slopes are expressed as RISE:RUN

SPECIFICATIONS:
"STANDARD SPECIFICATIONS FOR CONSTRUCTION OF ROADS
AND BRIDGES ON FEDERAL HIGHWAY PROJECTS, FP-14"

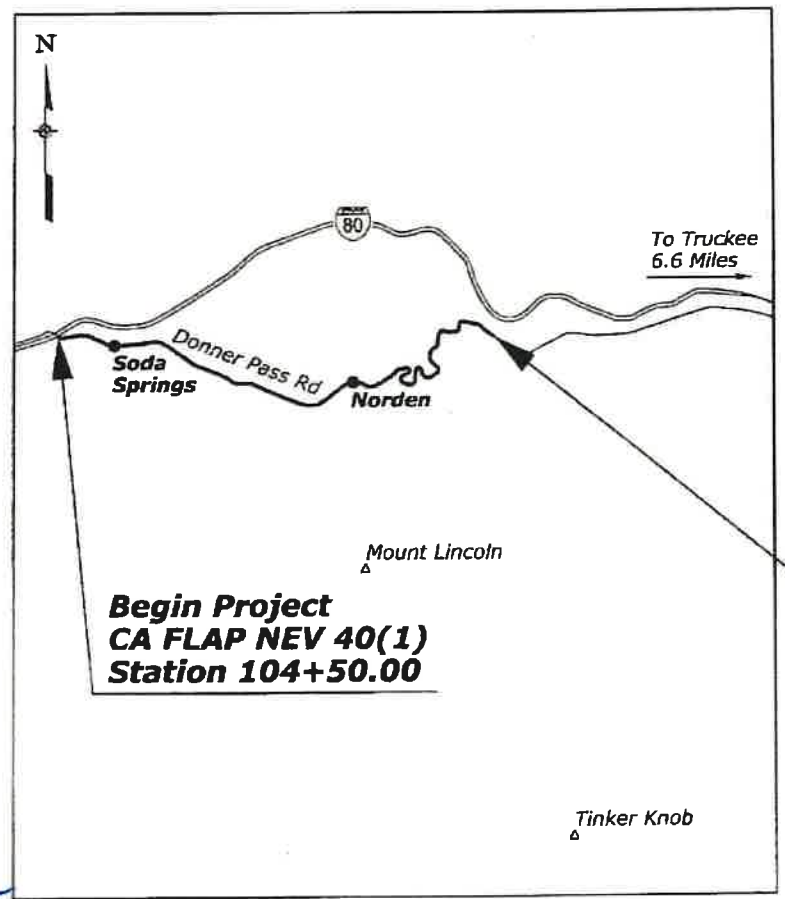

INDEX TO SHEETS	
SHEET	DESCRIPTION
A	GENERAL INFORMATION
A1	TITLE SHEET
A2 - A3	CONVENTIONAL PLAN SYMBOLS & ABBREVIATIONS
A4	SURVEY CONTROL
A5	SITE MAP
A6 - A7	TYPICAL SECTIONS
A8 - A9	PAVEMENT STRUCTURAL SECTIONS
A10 - A11	TYPICAL SECTIONS APPROACH ROADS
B	SUMMARIES
B1 - B4	SUMMARY OF QUANTITIES
B5	GRADING SUMMARY
B6 - B7	DRAINAGE SUMMARY
B8 - B9	SURFACING SUMMARY
B10	GUARDRAIL SUMMARY
B11	REMOVAL SUMMARY
B12 - B13	TABULATION OF QUANTITIES
B14 - B16	PERMANENT SIGN SUMMARY
B17	PERMANENT PAVEMENT MARKING SUMMARY
C	MAINLINE PLAN & PROFILE
C1 - C28	DONNER PASS PLAN AND PROFILES
D	MINOR ROAD, PULLOUT, PARKING, GEOMETRIC DETAILS
D1	RAINBOW BRIDGE PARKING AREA
D2 - D7	PULLOUT DETAILS
D8	DONNER SIDE RANCH STORM SYSTEM
F	DIVISION 200 STANDARDS/DETAILS AND SPECIALS
F1	EMBANKMENT BENCHING
F2	204-A SINGLE PATCHING DETAIL
G	DIVISION 250 STANDARDS/DETAILS AND SPECIALS
G1	ROCKERY WALL LAYOUT
G2	ROCKERY DETAIL
G3 - G25	ROCK CUT PLANS
G26 - G27	260-A ROCK REINFORCEMENT DETAIL
G28 - G30	GEOTEXTILE REINFORCED MSE WALL DETAILS
G31	C251-50 PLACED RIPRAP AT CULVERT OUTLETS
CONTINUED ON SHEET A2	

CONTRACTOR: HERBACK GENERAL ENGINEERING

FHWA COR: ALLEN REAVES

Work was constructed as designed unless otherwise noted

End Project
CA FLAP NEV 40(1)
Station 442+50.00

PLANS PREPARED BY
MULLER
ENGINEERING COMPANY



FOR
U.S. DEPARTMENT OF TRANSPORTATION
FEDERAL HIGHWAY ADMINISTRATION
CENTRAL FEDERAL LANDS HIGHWAY DIVISION
DENVER, COLORADO

APPROVED:

CHIEF OF ENGINEERING
CENTRAL FEDERAL LANDS HIGHWAY DIVISION

DATE: 9/3/2019

PROJECT MANAGER	LEAD DESIGNER
M. AMBROZIAK	MULLER

ABBREVIATIONS

∇	centerline
Δ	curve delta
$\emptyset$	diameter
A abut.	abutment
ADT	average daily traffic
aggr.	aggregate
AH	ahead
alt.	alternate
appr.	approach
asph.	asphalt
B b.f.	both faces
beg.	beginning, begin
BK	back
BM	bench mark
BP	balance point
br.	bridge
brg.	bearing
C CBC	concrete box culvert
c-c	center to center
clr.	clear
CMP	corrugated metal pipe
Co.	county
col.	column
conc.	concrete
constr.	construction
constr. jt.	construction joint
cont.	continuous
corr.	corrugated
cr.	creek
CS	point of curve to spiral
ctrs.	centers
CTSM	contingent sum
culv.	culvert
D decr.	decrement
DHV	design hour volume
DI	drop inlet
dia. or D	diameter
diag.	diagonal
diaph.	diaphragm
dist.	distance
Dist.	district
DLC	donation land claim
dwg(s).	drawing(s)
E E	east
e	superelevation rate
El. 94.066	elevation with number
elev.	elevation
emb.	embankment
enr(s).	Engineer(s)
EOP	edge of pavement
EQ or eq.	equation
ER	edge of road
et al	and others
et ux	and wife
EW	edge of water
exc.	excavation
exp. jt.	expansion joint
ext.	exterior
f.f.	fill face
Fed.	federal
FES	flared end section
fin.	finish
ftg.	footing
G ga.	gage (gauge)
galv.	galvanized
gdr.	girder
H hdwl.	headwall
HES	homestead entry survey
hex.	hexagon
horiz.	horizontal
HW	high water
hwy.	highway
I ID	inside diameter
incl.	inclusive, including
incr.	increment
int.	interior
J jt.	joint

L L	length of curve
lam.	lamination
lat.	latitude
long.	longitudinal
LPSM	lump sum
Lt. or LT	left
LW	low water
M mag.	magnetic
maint.	maintenance
matl.	material
max.	maximum
min.	minimum
mon.	monument
mntn(s).	mountain(s)
N N	north
NC	normal crown
neg.	negative
no. or #	number
O o.c.	on centers
o.f.	other face
OD	outside diameter
P PC	point of curve
PCC	point of compound curve
perf.	perforate
PI	point of intersection
pl.	plate
POC	point on curve
POS	point on spiral
POT	point on tangent
proj.	project
psi	pounds per square inch
PT	point of tangent
pvmnt.	pavement
Q quant., Qty	quantities
R R	radius
R.	range
R/W	right-of-way
rd.	road
rdwy.	roadway
reconst.	reconstruction
reinf.	reinforcement
reqd.	required
res.	reservoir
Res.	Reservation
ret. wall	retaining wall
RH	reference hub
Rt. or RT	right
rte.	route
S S	south
SADT	seasonal average daily traffic
SC	point of spiral to curve
sec.	section
shldr.	shoulder
spa.	spacing, Spaces or Spaced
spec.	specification
st.	street
ST	point of spiral to tangent
sta.	station
std.	standard
stiff.	stiffener
str.	straight
struc.	structural
sym.	symmetrical
T T	tangent length
T.	township
tan.	tangent
TBM	temporary bench mark
TCE	temporary construction easement
transv.	transverse
TS	point of tangent to spiral
typ.	typical
V V	design speed
vert.	vertical
vph	vehicles per hour
VPI	vertical point of intersection
W W	west

DRAINAGE SYMBOLS

Ditch (Existing, Proposed)

Flow Arrow

Drainage or Small Creek

Lake, Pond or Reservoir

Large Creek

Wetland

River

Spring

Bridge (Existing, Proposed)

Box Culvert (Existing, Proposed)

Pipe Culvert (Existing, Proposed)

With End Sections (Existing, Proposed)

With Headwalls (Existing, Proposed)

With Drop Inlet (Existing, Proposed)

Underdrain (Existing, Proposed)

Riprap Apron (Proposed)

EROSION & SEDIMENT CONTROL SYMBOLS

Bonded Fiber Matrix Mulching

Check Dam

Diversion Berm

Rolled Erosion Control Product

Riprap

Fiber Roll (Ditch and/or Cut Slope)

Silt Fence

Temporary Inlet Protection

Fiber Roll (Slope Protection)

FENCE & CATTLEGUARD SYMBOLS

Fence (Existing, Proposed)



Fence w/ Gate (Existing, Proposed)

Cattleguard (Existing, Proposed)

GEOLOGIC SYMBOLS

Boring Location (Existing, Proposed)

Material Source

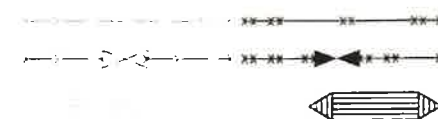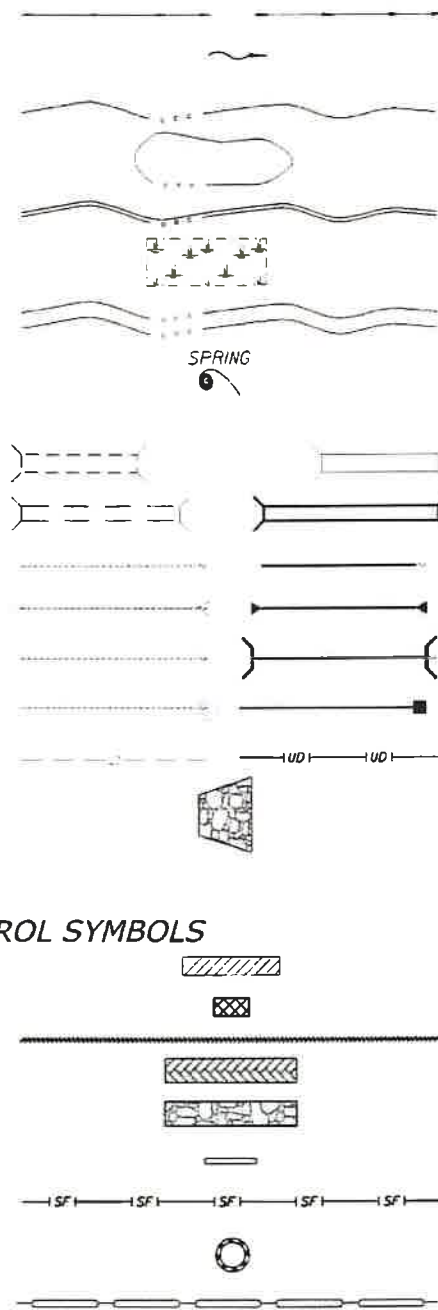

STATE	PROJECT	SHEET NUMBER
CA	CA FLAP NEV 40(1) DONNER PASS	A2

INDEX TO SHEETS (CONTINUED FROM SHEET A1)	
SHEET	DESCRIPTION
T	DIVISION 600 LAYOUTS, STANDARDS/DETAILS AND SPECIALS
T1	601-3 WINGWALLS FOR CONCRETE HEADWALLS
T2	601-4 CONCRETE HEADWALL FOR SMALL PIPE CULVERT
T3	602-A DRAINAGE DETAILS
T4	602-1 METAL PIPE CULVERT
T5	602-2 METAL PIPE CULVERT COUPLING BAND
T6	602-3 METAL AND PLASTIC PIPE CULVERT BEDDING
T7	602-4 METAL END SECTIONS
T8	602-5 PLASTIC PIPE CULVERT
T9	602-7 CONCRETE PIPE CULVERT INSTALLATION
T10	602-8 CONCRETE END SECTION FOR ROUND PIPE
T11	602-9 METAL END SECTION WITH SAFETY BARS
T12	604-A R.C.P. MANHOLE FOR CLOSED CONDUIT SYSTEM
T13	604-B INLET TYPE 7A AND 7B FOR 12" TO 36" CULVERT
T14	604-C GRATE DETAILS NO. 2
T15	604-5 INLET TYPE 5A
T16	604-6 FRAME AND GRATE TYPE 5A
T17 - T18	609-A CURB DETAILS
T19	609-B GUTTER DETAILS
T20	615-2 WHEELCHAIR RAMP CURB TAPER
T21	617-13 G4 AND MGS W-BEAM GUARDRAIL INSTALLATION IN ROCK
T22	617-14 G4 W-BEAM LOW SPEED TERMINAL TYPE LST, WOOD POSTS
T23	617-15 G4 W-BEAM GUARDRAIL MELT, LST & CRT ANCHORAGE ASSEMBLY DETAILS
T24	617-19 G4 AND MGS W-BEAM GUARDRAIL TYPE FLARED TERMINAL AND GRADING
T25	617-20 G4 AND MGS W-BEAM GUARDRAIL TYPE TANGENT TERMINAL AND GRADING
T26	617-28 G4 W-BEAM GUARDRAIL CONNECTION TO STRUCTURE SAFETY SHAPE FACE STEEL POSTS
T27	617-29 G4 BEAM GUARDRAIL CONNECTION TO STRUCTURE SAFETY SHAPE FACE RUBRAIL
T28	617-32 MGS W-BEAM GUARDRAIL STEEL POSTS
T29	617-37 MGS W-BEAM GUARDRAIL LONG-SPAN SYSTEM
T30	617-39 G4 TO MGS W-BEAM GUARDRAIL TRANSITION
T31	617-50 G4 W-BEAM GUARDRAIL WOOD POSTS
T32 - T33	618-A CONCRETE BARRIER
T34 - T41	619-A ROAD CLOSURE GATE (DROP ARM)
T42	619-B ROAD CLOSURE GATE (SWING ARM)
T43 - T59	SIGNING AND PAVEMENT MARKING PLANS
T60 - T64	633-A SIGN INSTALLATION
T65	633-B SPECIAL SIGN DETAIL
T66 - T67	633-C SNOW POLE DETAILS
T68	633-S1 DELINEATORS
T69	634-A RECESS PAVEMENT MARKING DETAIL
T70	634-B BICYCLE LANE PAVEMENT MARKINGS
T71	634-50 CENTERLINE STRIPING AND TOP LIFT PAVEMENT JOINT
T72	635-1 TEMPORARY TRAFFIC CONTROL ADVANCE SIGNING
T73	635-2 TEMPORARY PAVEMENT MARKINGS
T74	635-3 DELINEATION AND SIGNING FOR UNMARKED PAVEMENTS
T75	635-4 TEMPORARY TRAFFIC CONTROL FOR DIVERSION
T76	635-5 TEMPORARY TRAFFIC CONTROL ROAD CLOSURE LAYOUT (WITH FLAGGERS)
T77	635-6 TEMPORARY TRAFFIC CONTROL SINGLE LANE CLOSURE LAYOUT (WITH FLAGGERS)
T78	635-9 TEMPORARY TRAFFIC CONTROL SINGLE LANE CLOSURE LAYOUT (WITH SIGNALS)
T79	635-10 TEMPORARY TRAFFIC CONTROL SHOULDER CLOSURE LAYOUT
T80	635-11 TEMPORARY TRAFFIC CONTROL PART LANE WIDTH AND SHOULDER CLOSURE LAYOUT
T81	635-14 TEMPORARY TRAFFIC CONTROL SIGN INSTALLATION WOOD POSTS



7:03:43 AM Q:\2015 Projects\15-030.02 Donner Pass Preliminary Design - CLEHD\CA FLAP NEV 40(1)\Roadway\CADD_Sheets\A-Gen_Sht\SYM\DONN\CA40_02.dgn User: mcarlson

LANDSCAPING & VEGETATION SYMBOLS

Tree

Treeline

MAPPING SYMBOLS

Building (Existing, Proposed)

Coordinate Grid Tick

North Arrow

Railroad
Single Track

Double Track

Spot Elevation
999.9

Trail

Survey Control Point

RIGHT-OF-WAY SYMBOLS

Boundaries

National

State

County

City

Township or Range Line

Section

1/4 Section

1/16 Section

Bureau of Indian Affairs

Bureau of Land Management

National Forest

National Park

National Wildlife Refuge

Easements

Permanent (Existing)

Permanent (Proposed)

Temporary (Proposed)

Monument (As described)

Parcel Number

Property Line

Right-of-Way Line (Existing)

Right-of-Way Line (Proposed)

Section Corner (Found, Projected)

1/4 Section Corner (Found, Projected)

1/16 Section Corner (Found)

GUARDRAIL, BARRIER & WALL SYMBOLS

Guardrail (Existing, Proposed)

Guardwall (Existing, Proposed)

Median & Side Barrier (Existing, Proposed)

Retaining Wall (Existing, Proposed)

ROADWAY SYMBOLS

Clearing/Construction Limits

Slope Stake Limits

Top of Cut

Transition

Toe of Fill

Edge of Roadway

Existing

Proposed

Roadway Centerline (With Station ticks)

Roadway Obliteration

SIGN SYMBOLS

Signs

Commercial (Existing, Proposed)

Delineator (Existing)

Portable (Proposed)

Post Mounted (Existing, Proposed)

UTILITY SYMBOLS

Irrigation Ditch

Underground (Existing, Proposed)

Surface (Existing, Proposed)

Support Pole (Existing, Proposed)

Support Pole Anchor (Existing, Proposed)

Street Light (Existing, Proposed)

Telephone Booth (Existing, Proposed)

Telephone Pedestal (Existing, Proposed)

Underground Utility (Existing, Proposed)

CATV

Fiber Optic

Gas

Oil

Power

Sanitary Sewer

Telephone

Water

Overhead Utility Line (Existing, Proposed)

CATV

Fiber Optic

Power

Telephone

PROJECT SPECIFIC SYMBOLS

Type E snow pole

Type F snow pole


STATE	PROJECT	SHEET NUMBER
CA	CA FLAP NEV 40(1) DONNER PASS	A3



U.S. DEPARTMENT OF TRANSPORTATION
FEDERAL HIGHWAY ADMINISTRATION
CENTRAL FEDERAL LANDS HIGHWAY DIVISION

**CONVENTIONAL PLAN
SYMBOLS AND ABBREVIATIONS**
Sheet 2 of 2

STATE	PROJECT	SHEET NUMBER
CA	CA FLAP NEV 40(1) DONNER PASS	A4

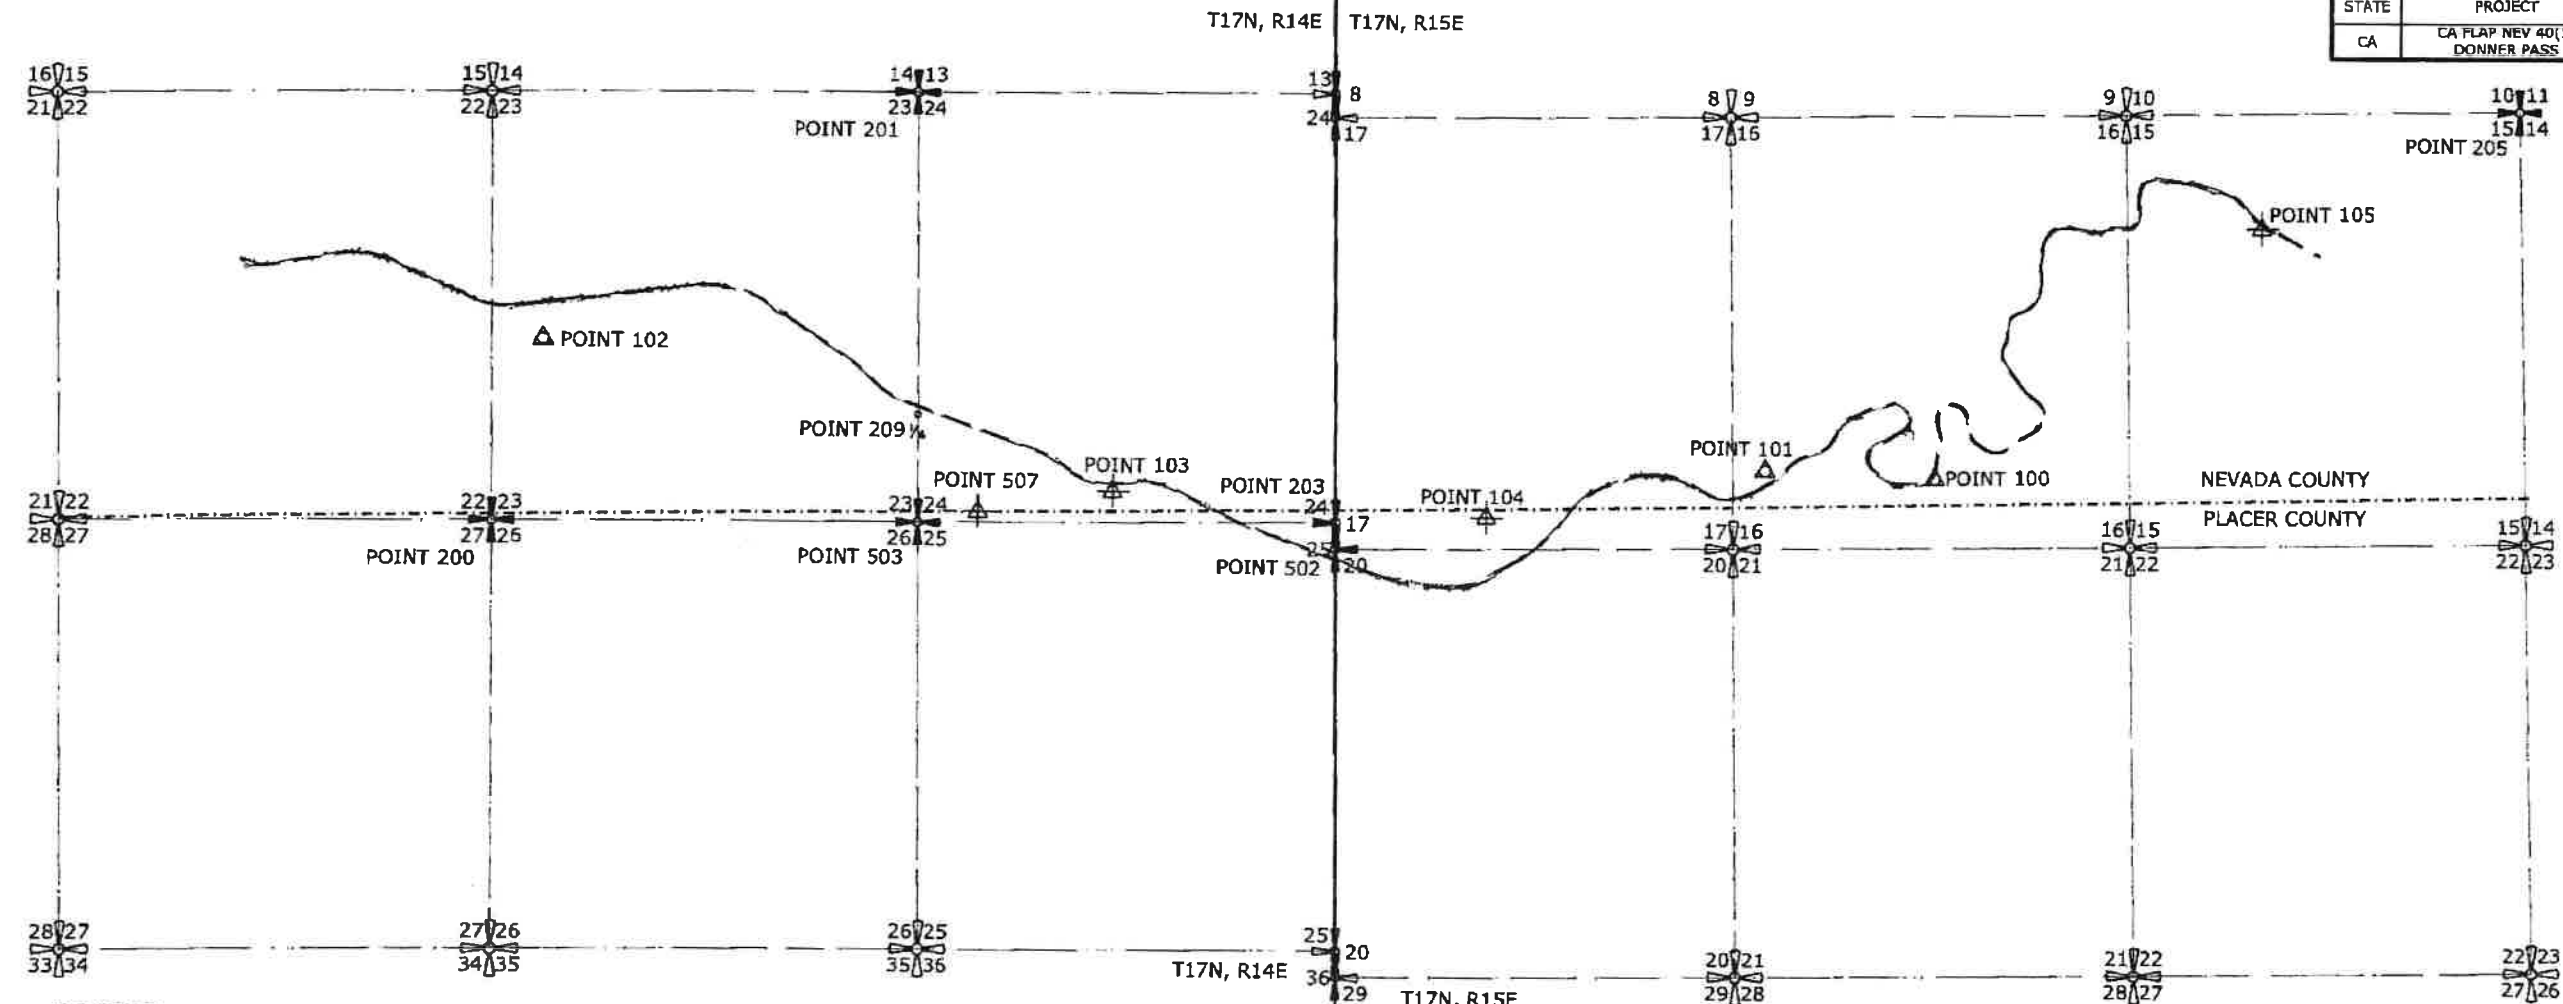

PRIMARY CONTROL

POINT NUMBER	STATE PLANE COORDINATES			GEO COORDINATES			MAPPING ANGLE	COMBINED FACTOR	DESCRIPTION
	NORTH	EAST	ELEVATION	LATITUDE	LONGITUDE	ELLIPSOID HEIGHT			
100	2245948.63	7037590.39	6789.50	39°19'02.06400"N	120°19'03.61200"W	6713.07	1°03'40"	0.99960264	Brass Cap, USGS "V1201"
101	2246038.36	7035473.15	7192.78	39°19'03.36000"N	120°19'30.54000"W	7116.30	1°03'22"	0.99958343	Brass Cap, USGS "H226"
102	2247481.88	7020222.58	6761.81	39°19'20.35200"N	120°22'44.22000"W	6685.33	1°01'19"	0.99950432	Brass Cap, USGS "K835"
103	2245713.42	7027294.49	6964.52	39°19'01.59600"N	120°21'14.65200"W	6888.17	1°02'17"	0.99959428	Aluminum Cap, WCI Control Pt. 103
104	2245444.42	7031676.06	7316.54	39°18'58.10400"N	120°20'15.14400"W	7240.10	1°02'53"	0.99957743	Aluminum Cap, WCI Control Pt. 104
105	2249012.74	7041719.15	6174.22	39°19'31.58400"N	120°18'10.33200"W	6097.60	1°04'12"	0.99963258	Aluminum Cap, WCI Control Pt. 105

SECONDARY CONTROL

POINT NUMBER	STATE PLANE COORDINATES			GEO COORDINATES			MAPPING ANGLE	COMBINED FACTOR	DESCRIPTION
	NORTH	EAST	ELEVATION	LATITUDE	LONGITUDE	ELLIPSOID HEIGHT			
200	2245275.819	7019634.371	7001.43	39°18'58.44400"N	120°22'52.21200"N	5924.898	1°03'16"	0.99959247	Brass Cap, Sections 22 23 26 27
201	2250570.33	7024779.776	7107.758	39°19'50.05200"N	120°21'45.54000"N	7031.396	1°02'53"	0.99958843	Brass Cap, Sections 23 24 25 26
203	2245366.924	7030388.582	7226.975	39°18'57.67200"N	120°20'39.19200"N	7152.53	1°02'38"	0.99958159	Brass Cap, Sections 17 24 25
205	2250461.025	7041967.753	6332.89	39°19'45.33600"N	120°17'28.68000"N	6256.21	1°04'37"	0.99962530	Brass Cap, Sections 10 11 14 15
206	2248619.35	7024848.055	6887.29	39°19'10.99200"N	120°21'45.57600"N	5810.331	1°01'55"	0.99959815	Brass Cap, Sections 21 24
302	2245040.65	7030063.489	7081.089	39°18'54.46800"N	120°20'39.19200"N	7304.639	1°02'38"	0.99958818	Aluminum Cap, Sections 25 27 28
303	2245301.769	7024472.024	6765.017	39°18'57.99600"N	120°21'45.57600"N	6686.334	1°01'53"	0.99960373	Aluminum Cap, Sections 23 24 25 26
507	2245446.652	7025616.51	6784.239	39°18'59.25600"N	120°21'36.07200"N	5707.785	1°02'02"	0.99960254	3" Pipe, County Line Marker

LEGEND

- PROJECTED SECTION CORNER
- FOUND SECTION CORNER
- FOUND NGS POINT
- SET ALUMINUM CAP
- SECTION LINE
- RANGE LINE
- COUNTY LINE
- SIXTEENTH CORNER


PROJECT : CA FLAP NEV 40(1) - Donner Pass Road

DATE OF FIELD WORK : 2017
DATE OF FINAL ADJUSTMENT : 2017

PROJECT UNITS : US SURVEY FOOT
COORDINATE SYSTEM : Lambert Conformal NAD83; CA 02 0402
EPOCH DATE : NAD_83(2011)(EPOCH:2010.0000)
VERTICAL DATUM : NAVD88
COMBINED SCALE FACTOR : 0.99959827

NOTE: TO PRECISELY CHECK DISTANCES BETWEEN POINTS AS MEASURED ON THE GROUND :
INVERSE THE STATE PLANE COORDINATES AND DIVIDE THE COMPUTED DISTANCE
BY A MEAN COMBINED FACTOR OF THE TWO POINTS.

TO COMPUTE GEODETIC AZIMUTHS USE THE FOLLOWING FORMULA :
GEODETIC AZIMUTH = GRID AZIMUTH + MAPPING ANGLE

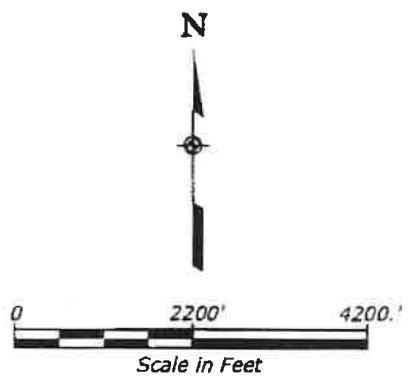

U.S. DEPARTMENT OF TRANSPORTATION
FEDERAL HIGHWAY ADMINISTRATION
CENTRAL FEDERAL LANDS HIGHWAY DIVISION


SURVEY CONTROL
RANGE 14E AND 15E
TOWNSHIP 17N

User: mcarlson

7:03:44 AM Q:\2015 Projects\15-030.02 Donner Pass Preliminary Design - CELHD\CA FLAP NEV 40(1)\Roadway\CADD_Sheets\A-Gen_sht\STATE(DONN)\CA40.dgn

3/21/2019

STATE	PROJECT	SHEET NUMBER
CA	CA FLAP NEV 40(1) DONNER PASS	A5

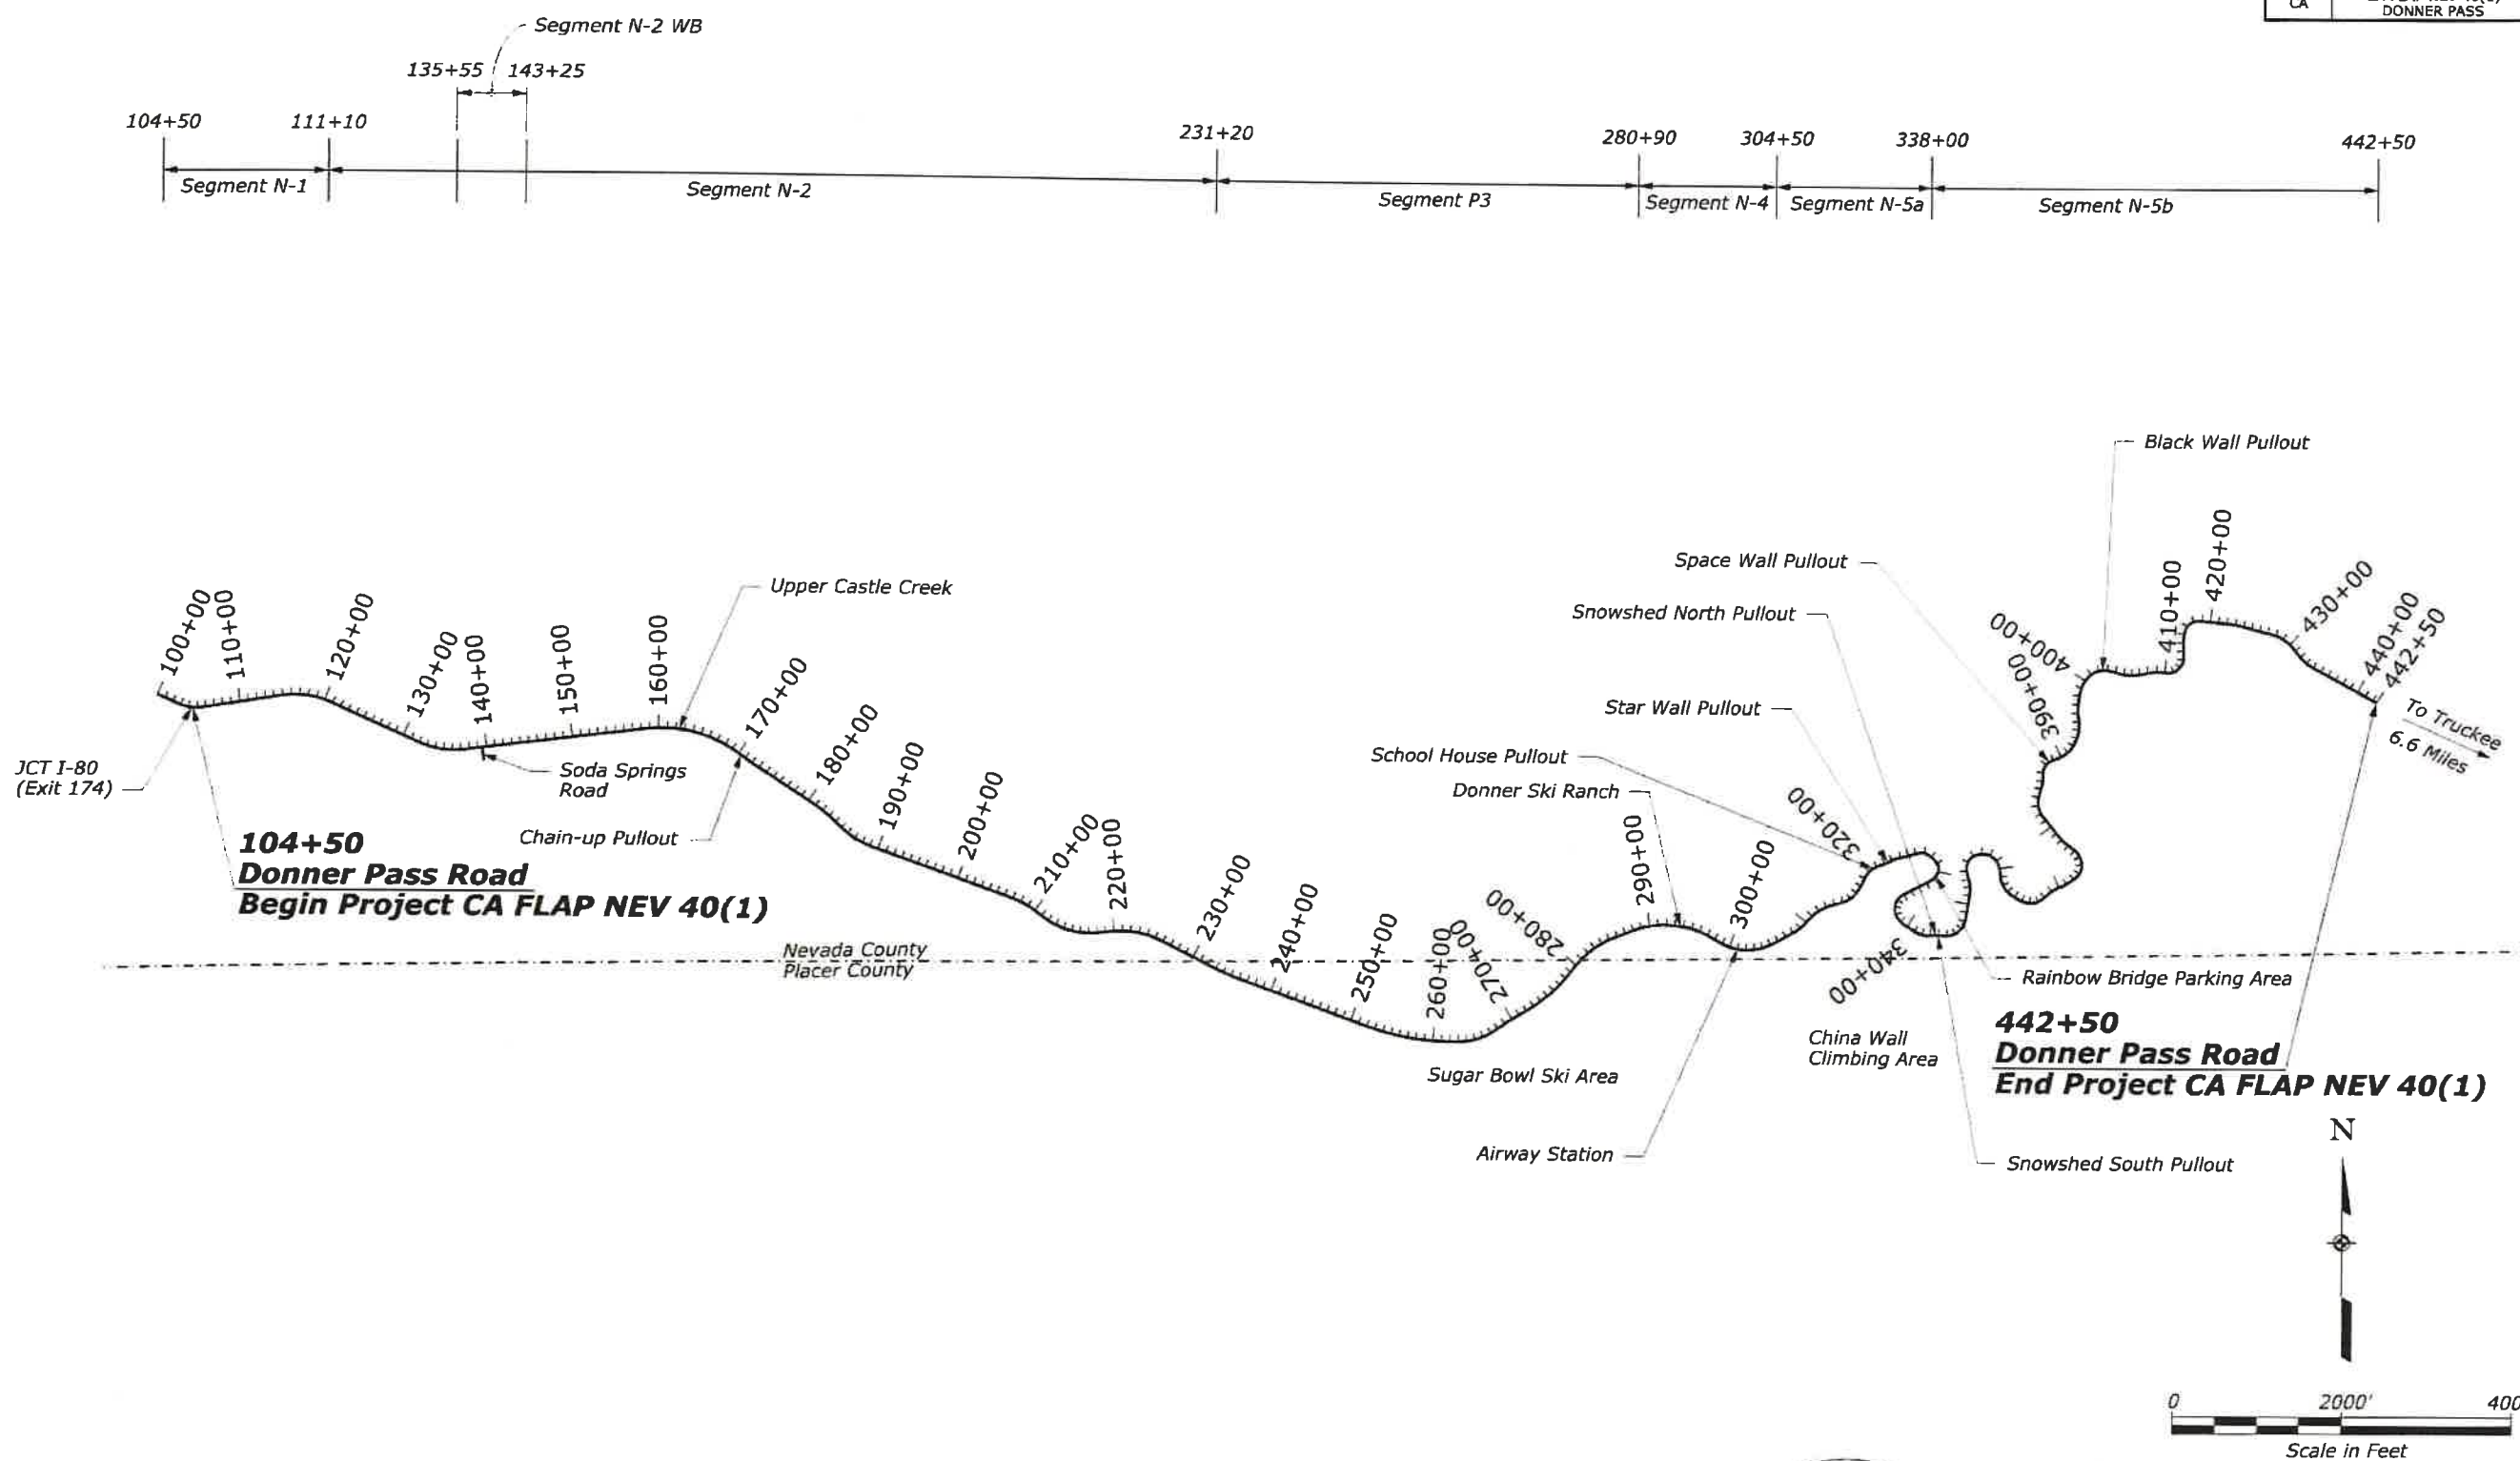

- Note:
1. Available staging area include pullouts located throughout the corridor. Staging areas are limited to previously disturbed areas.
 2. Segments used for pavement recommendations. See geotechnical and pavement recommendations for additional information.

DAVID
C 85264
Matthew David Anderson
4/11/2019
STATE OF CALIFORNIA


U.S. DEPARTMENT OF TRANSPORTATION
FEDERAL HIGHWAY ADMINISTRATION
CENTRAL FEDERAL LANDS HIGHWAY DIVISION

SITE MAP


User: marlton

11:17:59 AM Q:\2015 Projects\15-030.02 Donner Pass Preliminary Design - CADD\CA FLAP NEV 40(1) Roadway\CA40_01.dgn


8/15/2019

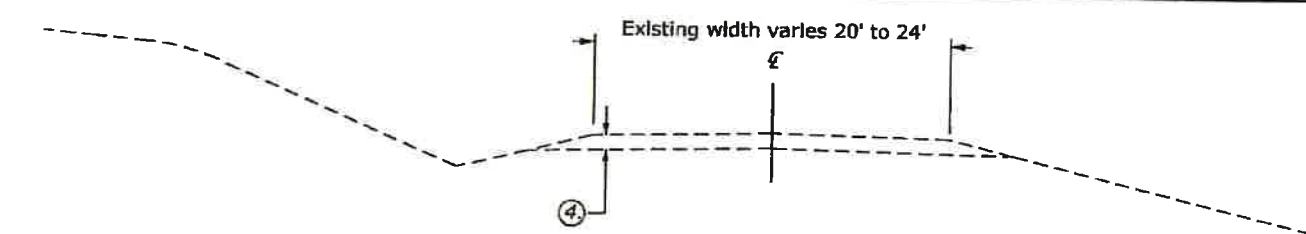


**EXISTING TYPICAL SECTION
104+50 to 442+50**

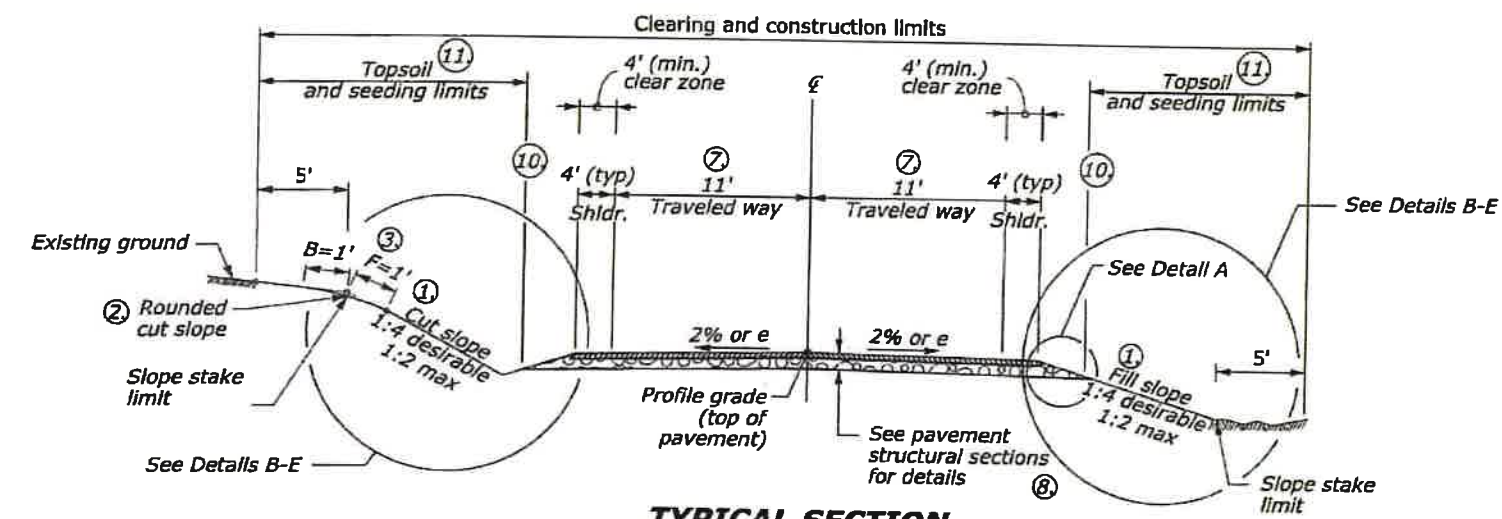

**TYPICAL SECTION
104+50 to 305+00**

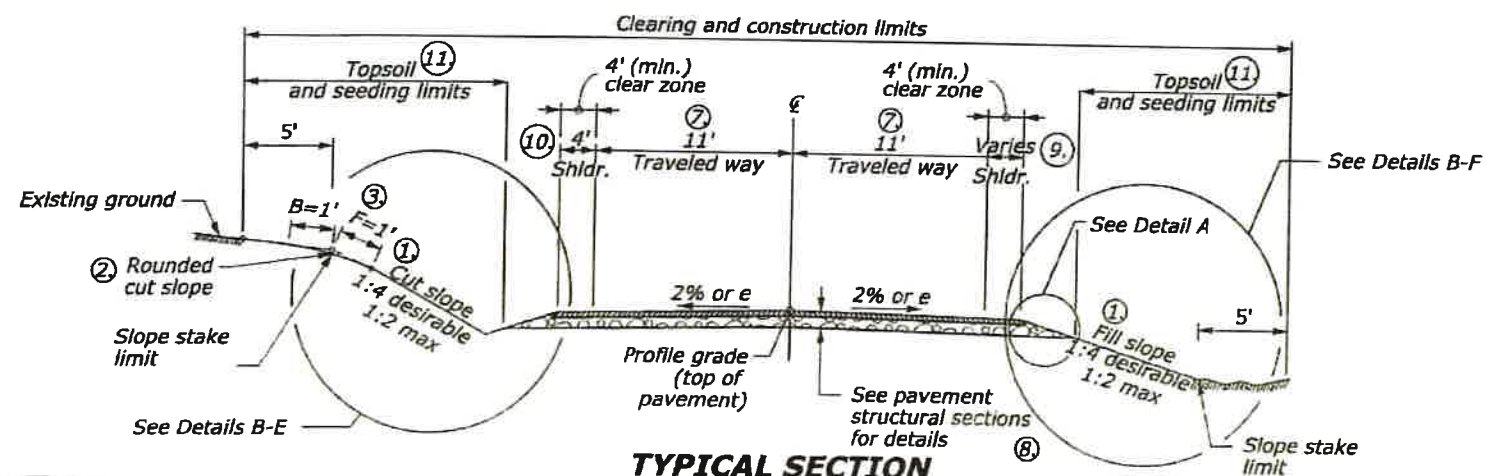


**TYPICAL SECTION
305+00 to 442+50**

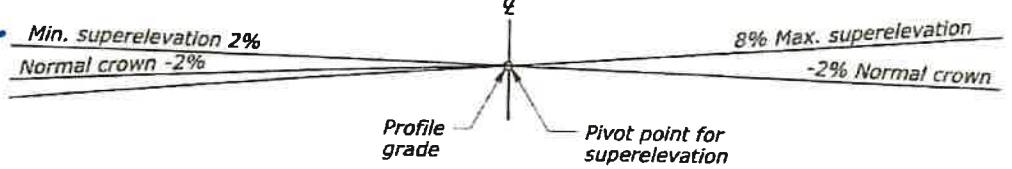

METHOD OF SUPERELEVATION ON CURVES
See plans for locations of curves and superelevations

NOTES:

1. See the cross sections for cut and fill slope ratios. See tabulations, plan and profile sheets and cross sections for application of details B-F. The gradient and width of roadway ditches and the excavation and embankment slope ratios may be adjusted by the CO to assure adequate drainage and stability.
2. Round all earth slopes and all rippable rock slopes.
3. Dimensions shown are approximate and may be varied by the CO.
4. Existing pavement depth varies. See Pavement Structural Sections and Geotechnical and Pavement Report for more information on existing pavement conditions.
5. Superelevated and widened sections are not shown.
6. Reshaping for traveled way, including superelevation, profile changes, and/or widening, includes the pulverizing and milling of the existing asphalt. The work of processing, spreading, hauling, stockpiling, placement, and compaction of pulverized and milled materials will not be paid for separately, but is included in the costs of FDR and asphalt pavement removal.
7. Where proposed road widens beyond edge of existing traveled way, rework subgrade as shown in the Geotechnical and Pavement Report and the widening detail. This work will be paid for as 30301-2000, Shoulder Reconditioning.
8. Sinkholes and voids may develop in subgrade during pulverization and subgrade preparation in pavement areas constructed on the existing rock fill. Fill and stabilize sinkholes and voids when called for by CO per Detail 204-A.
9. Match existing horizontal edge of asphalt concrete pavement.
10. See the cross sections for variations in shoulder cross slope.
11. Topsoil and seeding limits are excluded between 280+00 and 400+00 in locations where there is a rock face or rock slope.
12. Construct two foot wide bench sloping at two percent towards the roadway between Curb Type E and face of slope where terrain allows.

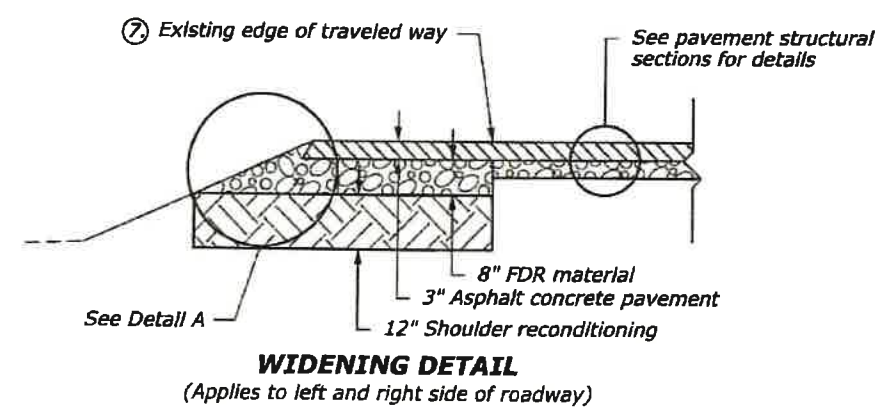

LENGTH OF PROJECT	
Station to Station	Roadway (ft)
104+50 to 442+50	33,800
TOTALS (ft)	33,800
TOTAL (mi)	6.4

NO SCALE

U.S. DEPARTMENT OF TRANSPORTATION
FEDERAL HIGHWAY ADMINISTRATION
CENTRAL FEDERAL LANDS HIGHWAY DIVISION







TYPICAL SECTIONS
Sheet 1 of 2



User: mcarhon

11:18:01 AM Q:\2015 Projects\15-030.02 Donner Pass Preliminary Design - CADD\CA FLAP NEV 40(1)\Roadway\CADD_Sheets\A-Gen_sht\TYP(DONN)CA40_01.dgn

8/15/2019

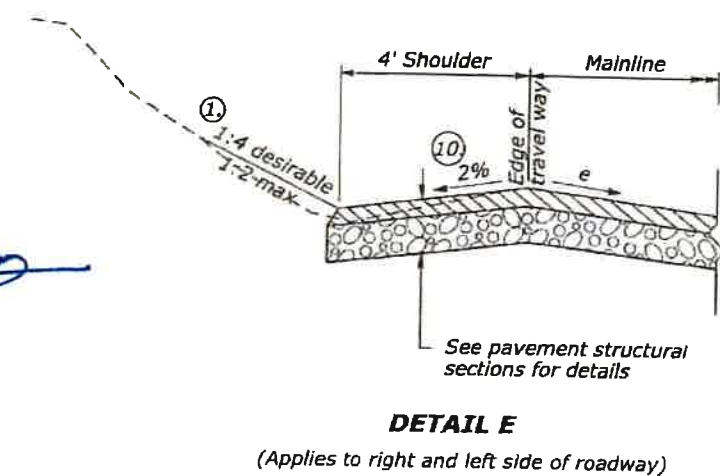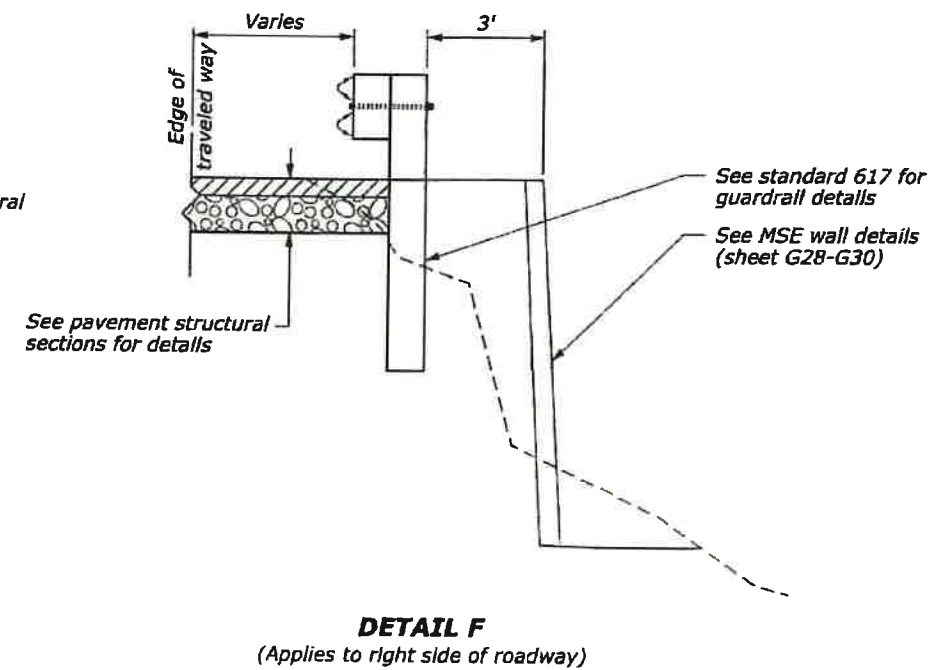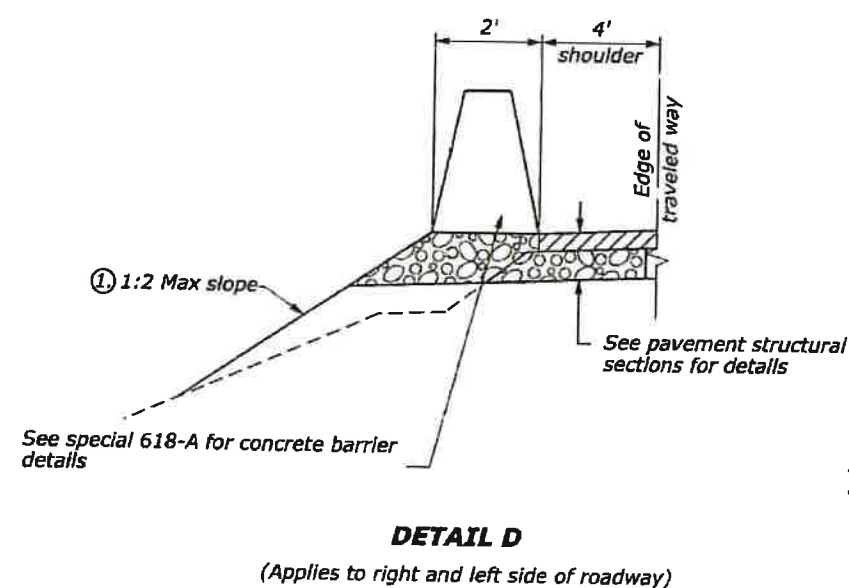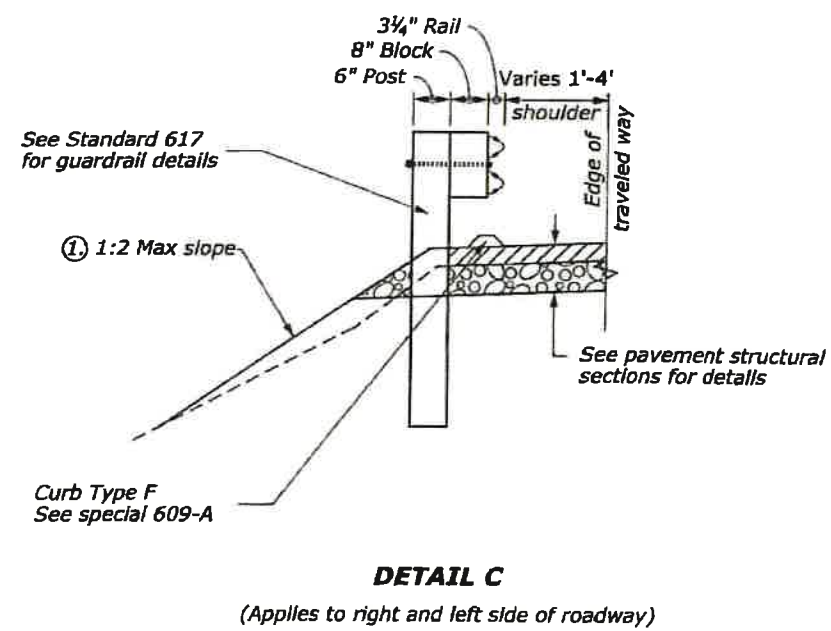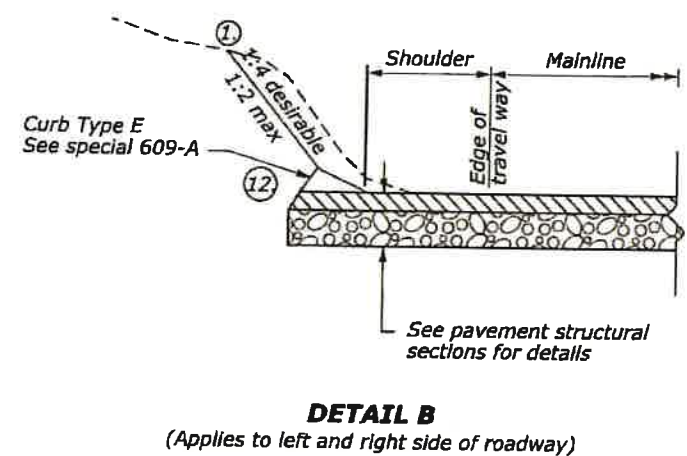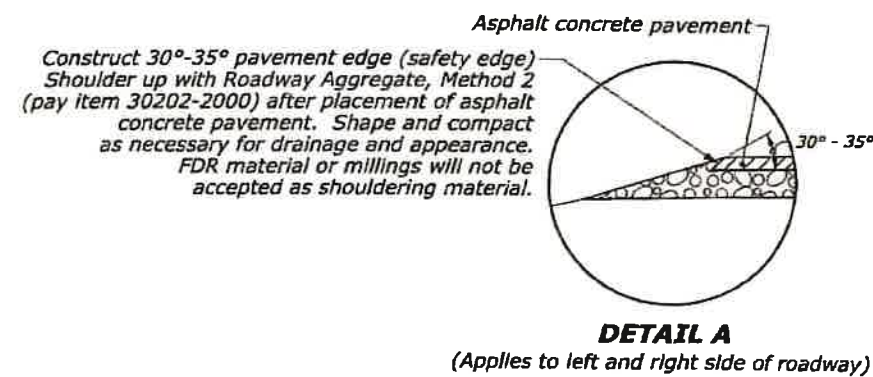

NOTES:

1. See the cross sections for cut and fill slope ratios. See tabulations, plan and profile sheets and cross sections for application of details B-F. The gradient and width of roadway ditches and the excavation and embankment slope ratios may be adjusted by the CO to assure adequate drainage and stability.
2. Round all earth slopes and all rippable rock slopes.
3. Dimensions shown are approximate and may be varied by the CO.
4. Existing pavement depth varies. See Pavement Structural Sections and Geotechnical and Pavement Report for more information on existing pavement conditions.
5. Superelevated and widened sections are not shown.
6. Reshaping for traveled way, including superelevation, profile changes, and/or widening, includes the pulverizing and milling of the existing asphalt. The work of processing, spreading, hauling, stockpiling, placement, and compaction of pulverized and milled materials will not be paid for separately, but is included in the costs of FDR and asphalt pavement removal.
7. Where proposed road widens beyond edge of existing traveled way, rework subgrade as shown in the Geotechnical and Pavement Report and the widening detail. This work will be paid for as 30301-2000, Shoulder Reconditioning.
8. Sinkholes and voids may develop in subgrade during pulverization and subgrade preparation in pavement areas constructed on the existing rock fill. Fill and stabilize sinkholes and voids when called for by CO per Detail 204-A.
9. Match existing horizontal edge of asphalt concrete pavement.
10. See the cross sections for variations in shoulder cross slope.
11. Topsoil and seeding limits are excluded between 280+00 and 400+00 in locations where there is a rock face or rock slope.
12. Construct two foot wide bench sloping at two percent towards the roadway between Curb Type E and face of slope where terrain allows.

STATE	PROJECT	SHEET NUMBER
CA	CA FLAP NEV 40(1) DONNER PASS	A7

U.S. DEPARTMENT OF TRANSPORTATION
FEDERAL HIGHWAY ADMINISTRATION
CENTRAL FEDERAL LANDS HIGHWAY DIVISION

TYPICAL SECTIONS


Sheet 2 of 2

NO SCALE


User: dhrung

Q:\2015 Projects\15-030.02 Donner Pass Preliminary Design - CFLHD\CA FLAP NEV 40(1)\Roadway\CADD_Sheets\A-Gen_sht\TYP(DONN)CA40_01.dgn


9/5/2019 10:42:34 AM

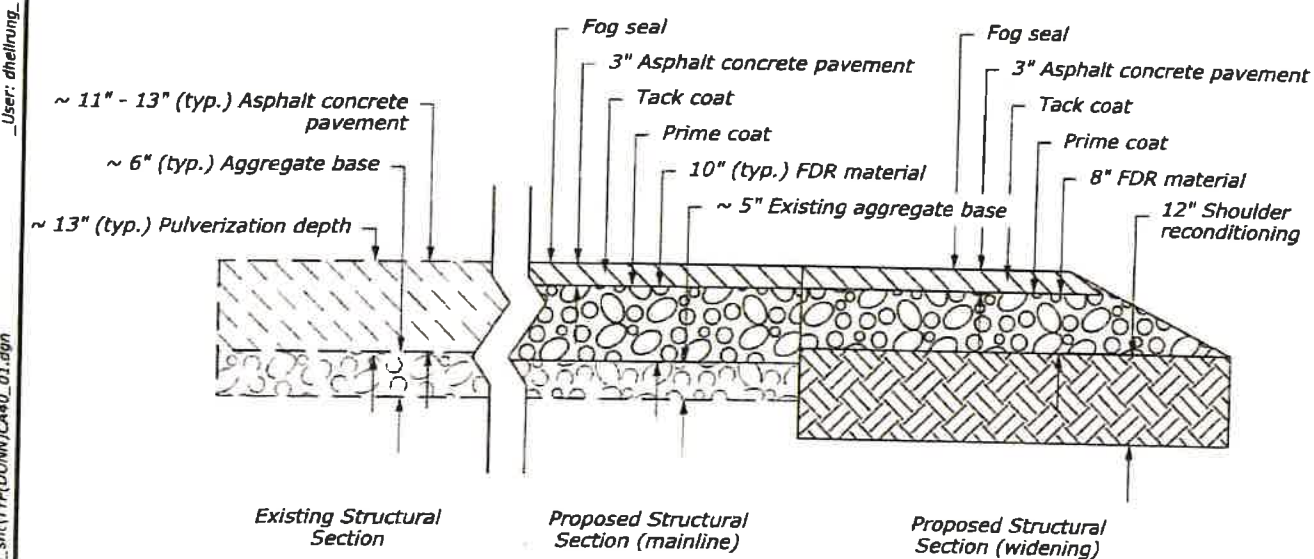


SEGMENT N-1 STRUCTURAL SECTION
104+50 TO 111+10

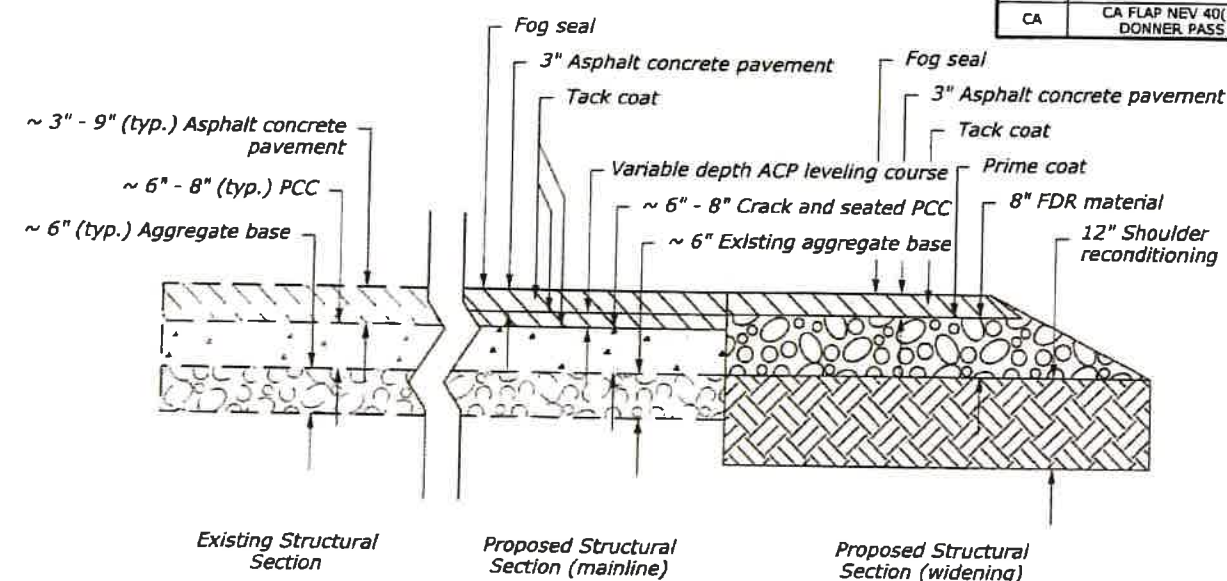

SEGMENT N-2 STRUCTURAL SECTION
111+10 TO 231+20

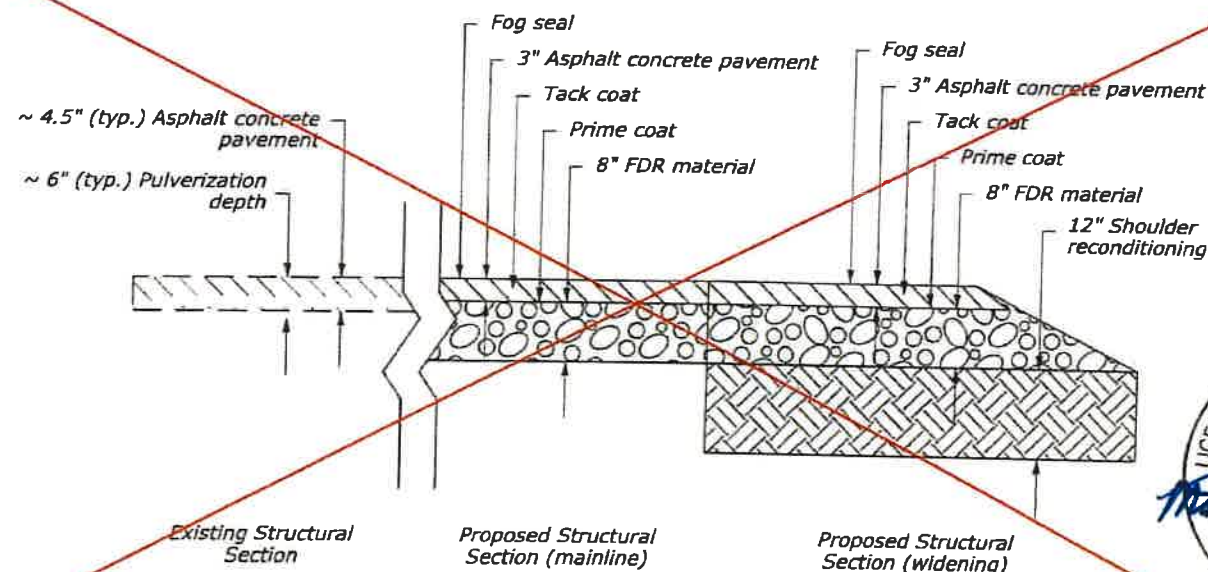

SEGMENT N-2 WB STRUCTURAL SECTION
135+55 TO 143+25

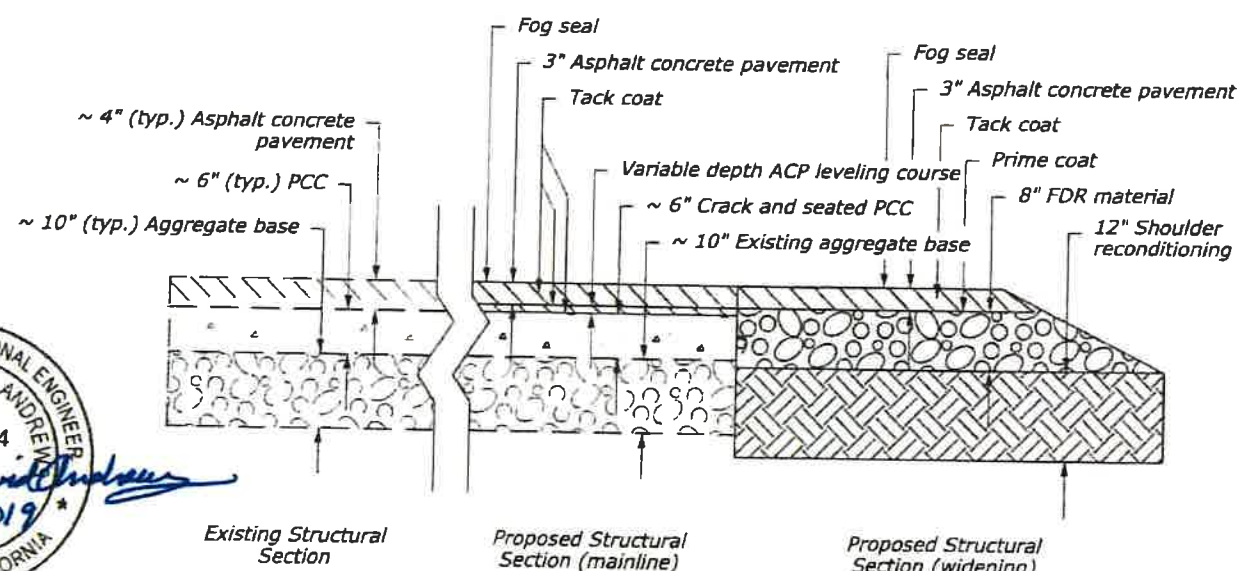

SEGMENT P-3 STRUCTURAL SECTION
231+20 TO 280+90

General Notes (All segments):

1. Apply prime coat prior to first asphalt lift.
2. Apply tack coat between asphalt lifts.
3. Apply fog seal to top asphalt lift.
4. Place asphalt concrete pavement in two equal lifts.
5. If bedrock is encountered within 11" of the proposed top of pavement, refer to CO for pavement section.
6. See Geotechnical and Pavement Report for more information on pavement structural section recommendations.
7. The minimum structural section for all segments is 3-inches of ACP over 8-inches of base material. Base material includes existing aggregate base, cracked and seated PCC and placed FDR material.

Notes for Segment N-1, N-2WB, N-4b, N-5a and N-5b:

8. Existing pavement section varies. Pulverize existing asphalt concrete pavement to a depth one inch below existing asphalt concrete pavement. Typical pulverization depth shown for quantity estimation only.

Notes for Segment N-2, P-3 and N-4a:

9. Existing pavement section varies. Remove existing asphalt concrete pavement by milling and grinding to expose existing PCC pavement.
10. Asphalt millings shall be reused as minor aggregate base and can be substituted for FDR material as shown on the plans. Process and adjust gradation of asphalt millings as needed to make material suitable for compaction.
11. Crack and seat existing PCC pavement in-place with multi-head breaker.
12. Where the elevation difference between exposed cracked and seated PCC and finished grade is less than or equal to 5-inches, place a variable depth asphalt concrete pavement leveling course directly on cracked and seated PCC prior to placing top 3-inches to achieve asphalt concrete pavement finished grade elevations.




NO SCALE

U.S. DEPARTMENT OF TRANSPORTATION
FEDERAL HIGHWAY ADMINISTRATION
CENTRAL FEDERAL LANDS HIGHWAY DIVISION


PAVEMENT STRUCTURAL SECTIONS

Sheet 1 of 2

STATE	PROJECT	SHEET NUMBER
CA	CA FLAP NEV 40(1) DONNER PASS	A9

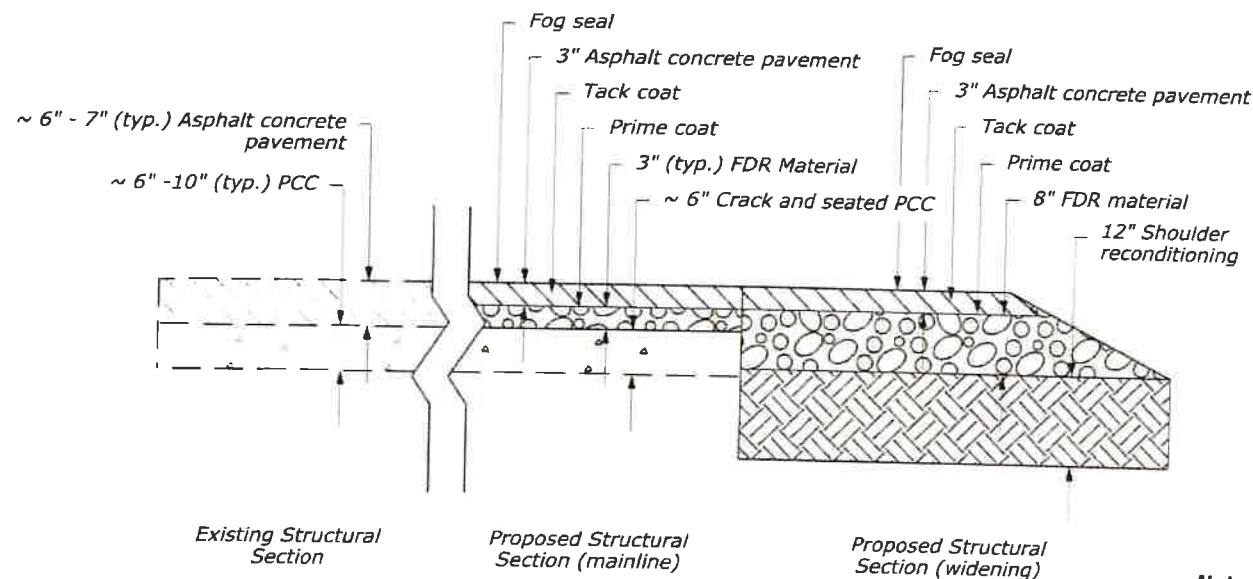


SEGMENT N-4a STRUCTURAL SECTION
280+90 to 304+50 305+27

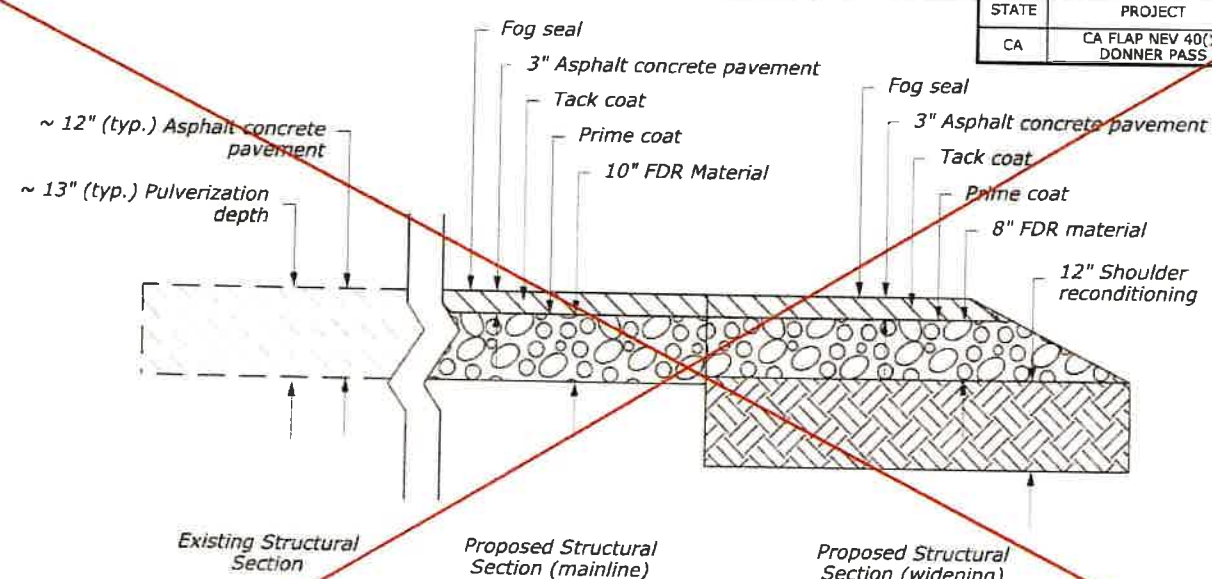


SEGMENT N-4b STRUCTURAL SECTION
280+90 to 304+50

Note:
If concrete pavement is encountered, use N-4a. If no concrete pavement is present use N-4b.

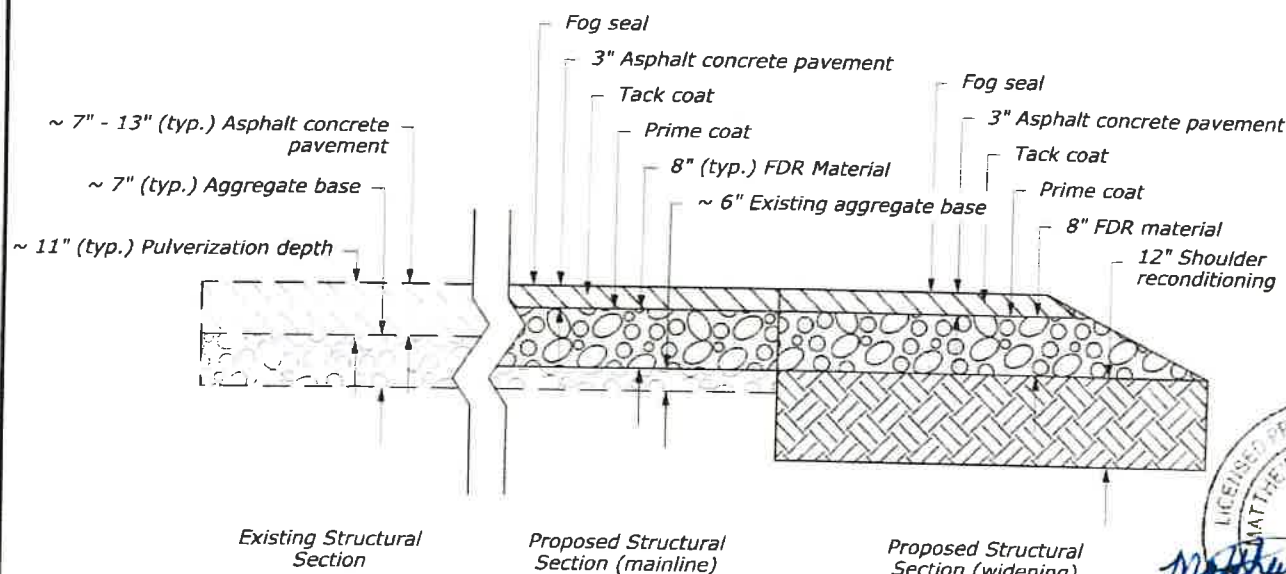

SEGMENT N-5a STRUCTURAL SECTION
305+27 304+50 to 338+00

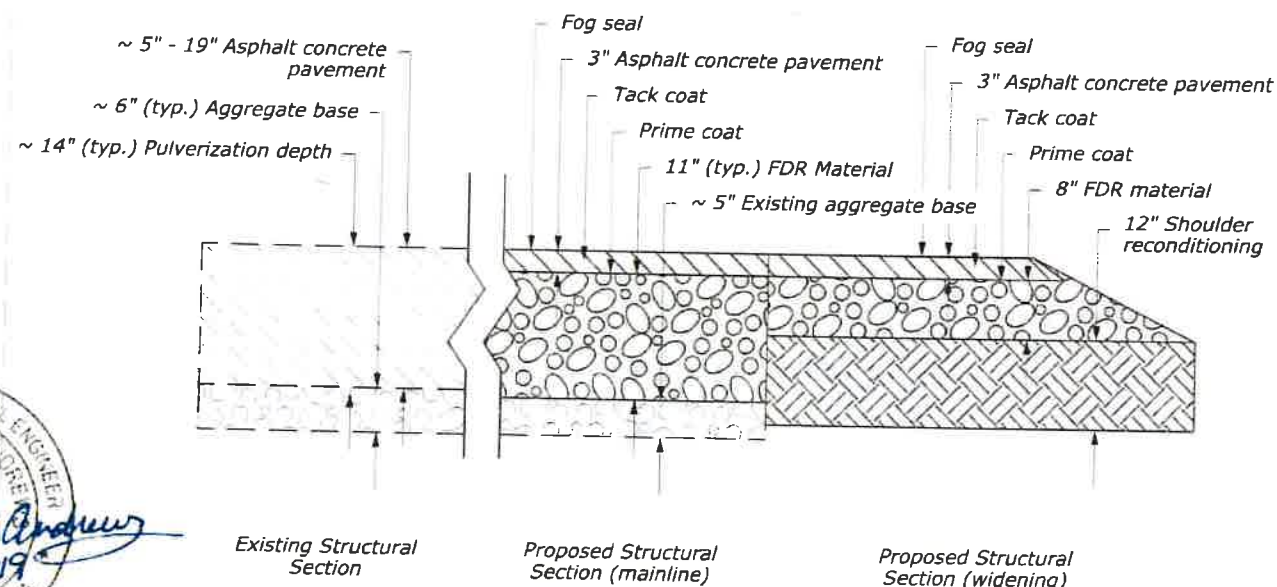

SEGMENT N-5b STRUCTURAL SECTION
338+00 to 442+50

General Notes (All segments):

1. Apply prime coat prior to first asphalt lift.
2. Apply tack coat between asphalt lifts.
3. Apply fog seal to top asphalt lift.
4. Place asphalt concrete pavement in two equal lifts.
5. If bedrock is encountered within 11" of the proposed top of pavement, refer to CO for pavement section.
6. See Geotechnical and Pavement Report for more information on pavement structural section recommendations.
7. The minimum structural section for all segments is 3-inches of ACP over 8-inches of base material. Base material includes existing aggregate base, cracked and seated PCC and placed FDR material.

Notes for Segment N-1, N-2WB, N-4b, N-5a and N-5b:

8. Existing pavement section varies. Pulverize existing asphalt concrete pavement to a depth one inch below existing asphalt concrete pavement. Typical pulverization depth shown for quantity estimation only.

Notes for Segment N-2, P-3 and N-4a:

9. Existing pavement section varies. Remove existing asphalt concrete pavement by milling and grinding to expose existing PCC pavement.
10. Asphalt millings shall be reused as minor aggregate base and can be substituted for FDR material as shown on the plans. Process and adjust gradation of asphalt millings as needed to make material suitable for compaction.
11. Crack and seat existing PCC pavement in-place with multi-head breaker.
12. Where the elevation difference between exposed cracked and seated PCC and finished grade is less than or equal to 5-inches, place a variable depth asphalt concrete pavement leveling course directly on cracked and seated PCC prior to placing top 3-inches to achieve asphalt concrete pavement finished grade elevations.

NO SCALE

U.S. DEPARTMENT OF TRANSPORTATION
FEDERAL HIGHWAY ADMINISTRATION
CENTRAL FEDERAL LANDS HIGHWAY DIVISION

PAVEMENT STRUCTURAL SECTIONS


Sheet 2 of 2




3:18:16 PM Q:\2015 Projects\15-030.02 Donner Pass Preliminary Design - CFLHD\CA FLAP NEV 40(1) Roadway\CADD_Sheets\A-Gen_sht\TYP(DONN)\CA40_01.dgn

4/2/2019


3/21/2019 7:03:53 AM Q:\2015 Projects\15-030.02 Donner Pass Preliminary Design - CFLHD\CA FLAP NEV 40(1) Roadway\CADD_Sheets\A-Gen_sht\TYP(DONN)CA40 Approach Roads_01.dgn User: mearison

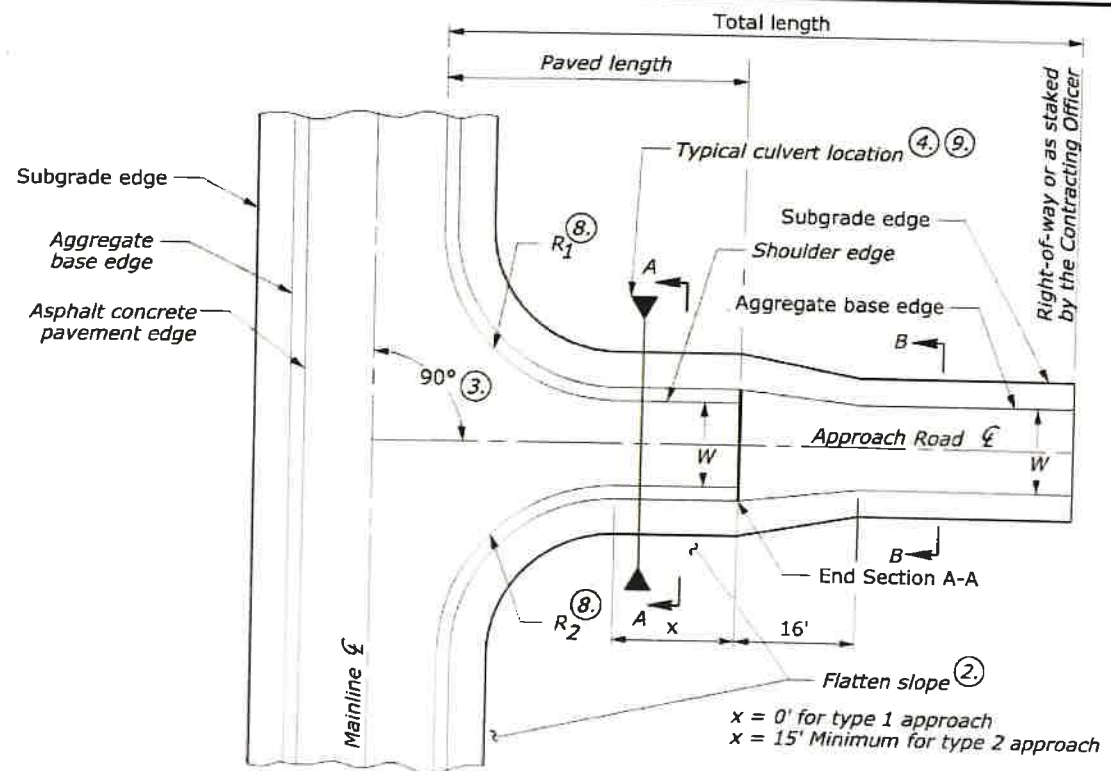


APPROACH ROAD
TYPES 1 & 2
TYPICAL PLAN

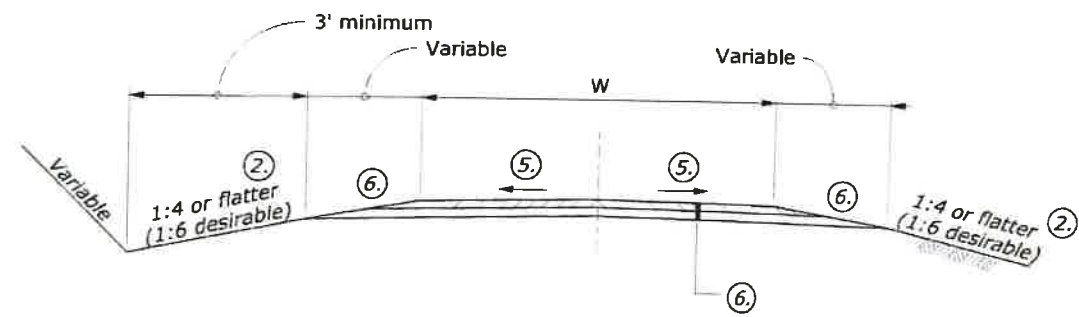


SECTION A-A

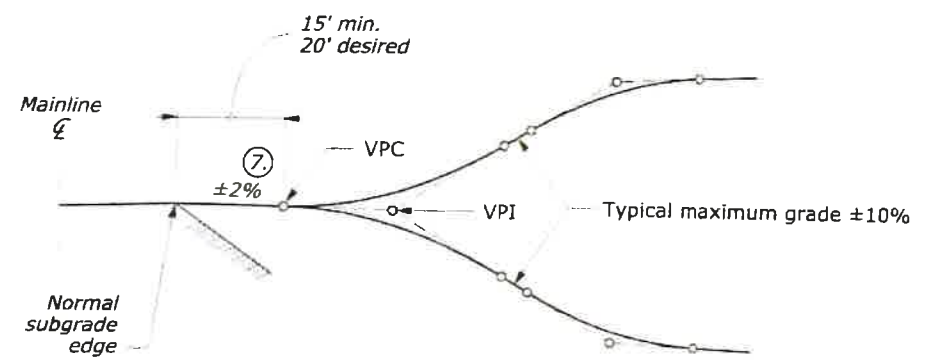

TYPICAL PROFILE

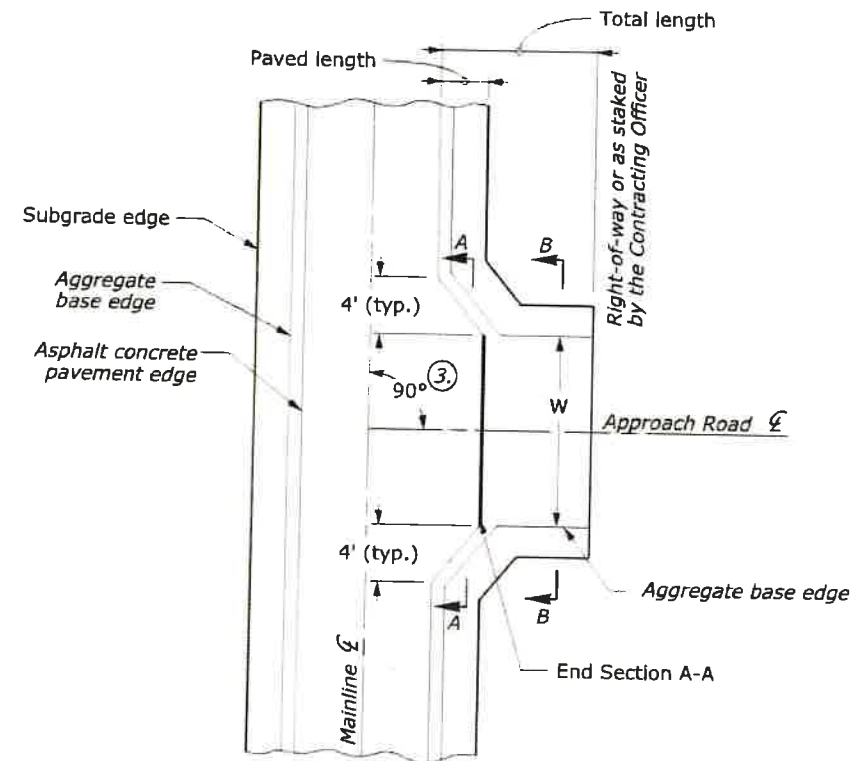

APPROACH ROAD
TYPE 3
TYPICAL PLAN

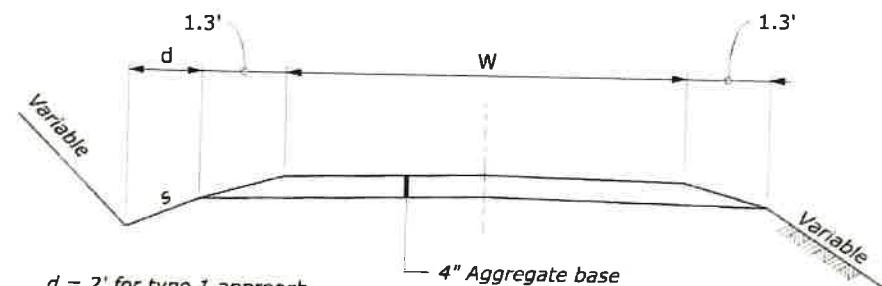

d = 2' for type 1 approach
d = 3' for type 2 approach
s = 1:3 for type 1 approach
s = 1:4 for type 2 approach


SECTION B-B

TYPE	CLASS	MIN. WIDTH W (ft)	MIN. RADIUS R (ft)	SAMPLE APPLICATION
1	A	12	15	Field Access
1	B	14	25	Minimum 1-Way Use
1	C	16	25	Farm Equipment
1	D	16	40	Logging Truck Use
2	A	18	25	Minimum 2-Way Use
2	B	20	25	ADT < 25
2	C	22	40	25 ≤ ADT < 100
2	D	24	40	100 ≤ ADT < 199
2	E	28	50	ADT ≥ 200
3	A	*	N/A	Paved apron

* Match existing

NOTE:

1. Stations shown are approximate locations. Actual locations to be field verified.
2. Construct cut and fill slopes for approach roads to match with mainline roadway construction.
3. Under special conditions, the approach road angle shown may be varied ±20°.
4. Place culverts at the end of the approach road radius to provide a flatter foreslope and increased mainline recovery area. When a culvert must be placed within the clear zone of the mainline roadway, use safety end sections (see Standard Drawing 602-9).
5. Apply the normal mainline crown section to approach roads with widths greater than 15 feet. For paved aprons at Type 3 approach roads, cross slope shall match mainline roadway grade.
6. Refer to mainline typical sections for structural section thicknesses and foreslopes.
7. Construct approach roads with landing areas having grades within ±2%. In snowy regions restrict this to a 0% to -2% grade. Under special conditions, use 6% maximum.
8. Vary radii to fit unusual field conditions. Do not reduce existing radii or widths. R₁ is on the left side of the approach road centerline.
9. Provide at least 12" of cover over driveway culverts. Use slurry if 12" of cover cannot be constructed based on field conditions.

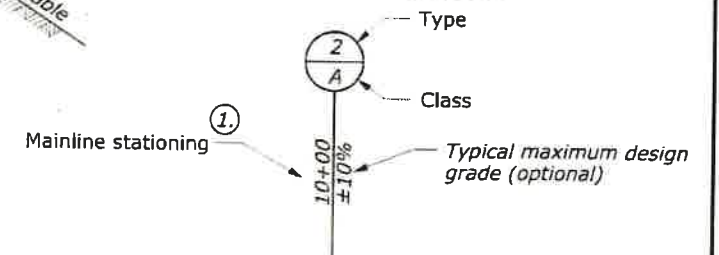

Example of symbol showing standard approach road connection on plan and profile sheet

TYPICAL SYMBOL

U.S. DEPARTMENT OF TRANSPORTATION
FEDERAL HIGHWAY ADMINISTRATION
CENTRAL FEDERAL LANDS HIGHWAY DIVISION

TYPICAL SECTIONS
APPROACH ROADS

Sheet 1 of 2




NO SCALE

APPROACH ROAD SUMMARY							
STATION	TYPE & CLASS	PAVED LENGTH (ft)	TOTAL LENGTH (ft)	W (ft)	R ₁ (ft)	R ₂ (ft)	REMARKS
109+00 Lt.	3A	4	4	704			
111+10 Rt.	3A	2	2	37			
115+70 Lt.	3A	12	12	66			
116+65 Rt.	3A	4	4	100			
116+75 Lt.	3A	5	5	30			
119+10 Rt.	3A	2	2	40			
119+40 Lt.	3A	6	6	40			
119+60 Rt.	3A	6	6	15			
120+00 Lt.	2A	50	50	24	*	*	Poma Lane
120+60 Rt.	3A	2	2	34			
123+37 Rt.	3A	8	8	24			
123+95 Rt.	3A	4	4	20			
124+05 Lt.	3A	6	6	50			
125+10 Lt.	2A	35	35	28	*	*	Uola Monte Lane
126+35 Lt.	3A	7	7	182			
126+60 Rt.	3A	10	10	317			
127+45 Lt.	3A	4	4	32			
128+93 Lt.	3A	15	15	32			
129+50 Rt.	3A	4	4	80			
129+80 Lt.	3A	2	15	20			
130+47 Lt.	3A	2	2	25			
132+00 Lt.	3A	10	10	36			
133+30 Lt.	3A	4	4	20			
134+05 Lt.	3A	6	6	24			
137+90 Rt.	3A	10	10	265			
137+93 Lt.	3A	4	4	26			Hill Road
139+55 Rt.	2E	22	22	30	*	*	Soda Springs Road
140+55 Rt.	3A	10	10	130			
140+63 Lt.	3A	4	4	26			
142+90 Rt.	3A	4	4	24			
143+95 Rt.	3A	4	4	12			
145+00 Rt.	3A	4	4	45			
145+40 Lt.	3A	4	4	55			
146+65 Rt.	3A	4	4	150			
148+57 Rt.	3A	4	10	20			
149+60 Lt.	3A	15	15	30			
150+60 Rt.	3A	4	4	230			
150+75 Lt.	3A	4	4	45			
151+80 Lt.	3A	4	4	78			
153+30 Lt.	3A	2	2	40			
153+50 Rt.	3A	4	12	58			
154+55 Lt.	3A	4	8	28			
155+00 Rt.	3A	4	4	25			
155+25 Lt.	3A	4	4	38			
156+35 Rt.	3A	4	4	107			
156+45 Lt.	3A	2	2	25			
158+05 Lt.	3A	6	6	20			
159+00 Rt.	3A	4	4	225			
160+08 Lt.	3A	2	2	33			

* Match existing

APPROACH ROAD SUMMARY (CONTINUED)							
STATION	TYPE & CLASS	PAVED LENGTH (ft)	TOTAL LENGTH (ft)	W (ft)	R ₁ (ft)	R ₂ (ft)	REMARKS
160+70 Lt.	3A	4	4	35			
161+70 Lt.	3A	12	12	43			
162+70 Lt.	3A	12	12	18			
170+80 Lt.	3A	4	4	28			Bunny Hill Drive
209+70 Lt.	3A	4	25	50			
211+50 Lt.	3A	10	10	45			
221+20 Lt.	3A	4	11	75			
223+90 Lt.	3A	4	4	15			
229+95 Lt.	3A	12	12	60			
249+45 Rt.	3A	4	20	20			
253+11 Rt.	3A	18	18	50			
255+85 Rt.	3A	4	4	15			
257+35 Rt.	3A	4	4	75			
258+95 Rt.	3A	15	15	30			
261+00 Lt.	3A	8	8	892			
261+10 Rt.	3A	5	5	50			Sugar Bowl
283+50 Lt.	3A	2	2	27			
284+00 Lt.	3A	2	2	18			
286+30 Lt.	3A	10	10	32			
292+00 Lt.	3A	12	12	495			
293+25 Rt.	2E	25	25	36	*	*	Sugar Bowl Ski Area
294+00 Rt.	3A	5	5	72			
296+79 Lt.	3A	2	18	25			
296+80 Rt.	3A	5	5	16			
304+35 Rt.	3A	18	18	145			Sugar Bowl Academy
372+20 Lt.	3A	5	5	30			
407+25 Rt.	3A	12	12	75			
423+47 Lt.	3A	6	6	60			

* Match existing

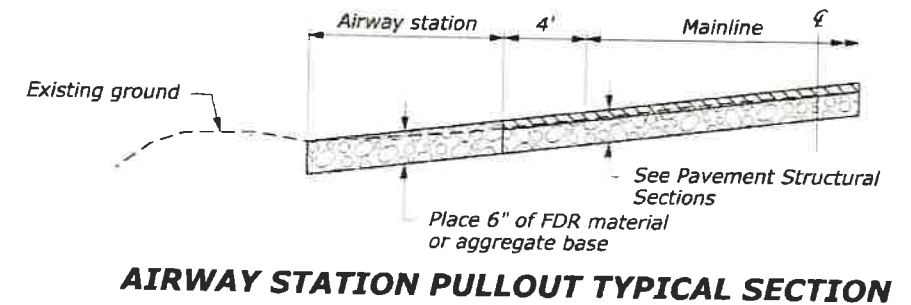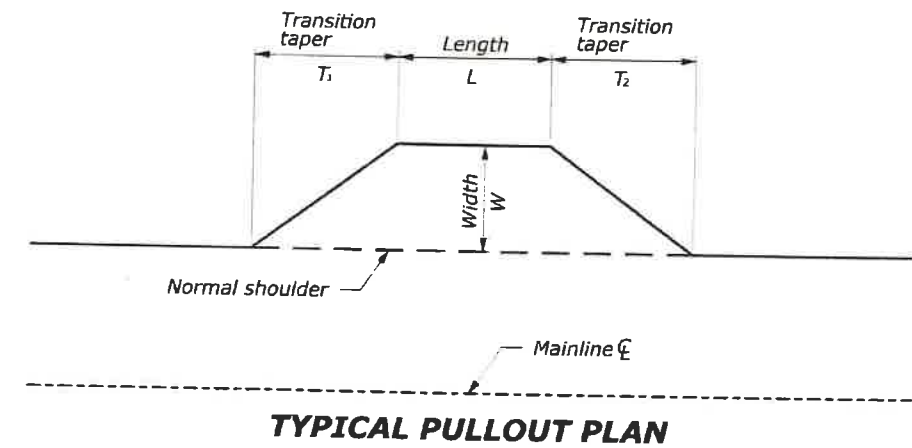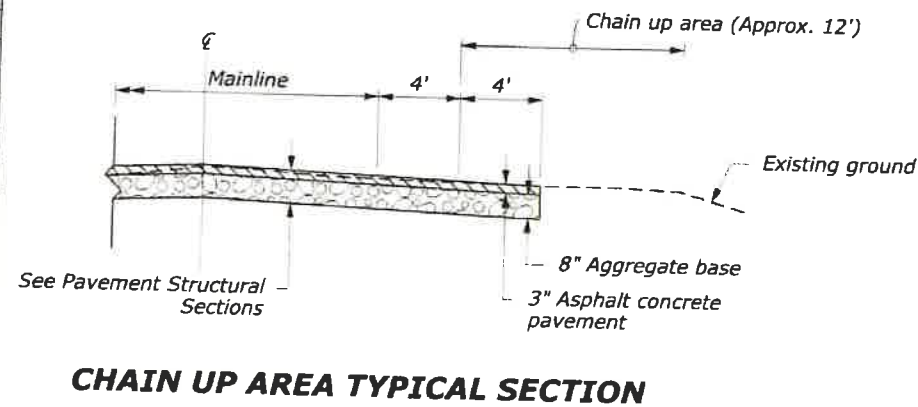

U.S. DEPARTMENT OF TRANSPORTATION
FEDERAL HIGHWAY ADMINISTRATION
CENTRAL FEDERAL LANDS HIGHWAY DIVISION

APPROACH ROAD AND PULLOUT SUMMARY

Sheet 2 of 2

NO SCALE

SUMMARY OF QUANTITIES

STATE	PROJECT	SHEET NUMBER
CA	CA FLAP NEV 40(1) DONNER PASS	B1

A M E N D	Line Item No.	Pay Item Number	Pay Item Description	Unit	Sheet and Description										Estimated Quantities	Remarks and/or Determination of Estimated Quantity
					B5	B6 - B7	B8 - B9	B10	B11	B12 - B13	B14 - B16	B17				
					GRADING SUMMARY	DRAINAGE SUMMARY	SURFACING SUMMARY	GUARDRAIL SUMMARY	REMOVAL SUMMARY	TABULATION OF QUANTITIES	PERMANENT SIGN SUMMARY	PERMANENT PAVEMENT MARKING SUMMARY	Allowance	Bid Schedule		
	A0020	15101-0000	MOBILIZATION	LPSM												
	A0040	15214-2000	SURVEY AND STAKING, RETAINING WALL	LPSM										ALL		
	A0060	15215-1000	SURVEY AND STAKING, APPROACH ROAD	EACH						ALL				ALL		
	A0080	15215-3000	SURVEY AND STAKING, DRAINAGE STRUCTURE	EACH						77				77		
	A0100	15215-7000	SURVEY AND STAKING, PARKING AREA	EACH		11								11		
	A0120	15225-0000	SLOPE, REFERENCE, AND CLEARING AND GRUBBING CONTROL	MILE						9				9		
	A0140	15236-2000	SURVEY CONTROL, GRADE FINISHING	MILE						6.400				6.400		
	A0160	15301-0000	CONTRACTOR QUALITY CONTROL	LPSM						6.400				6.400		
	A0180	15401-0000	CONTRACTOR TESTING	LPSM										ALL		
	A0200	15501-0000	CONSTRUCTION SCHEDULE	LPSM										ALL		
	A0220	15701-0000	SOIL EROSION CONTROL (Erosion Control)	LPSM										ALL		
	A0240	15701-0000	SOIL EROSION CONTROL (Sediment Control)	LPSM										ALL		
	A0260	15701-0000	SOIL EROSION CONTROL (Non-Stormwater Control)	LPSM										ALL		
	A0280	15704-1200	SOIL EROSION CONTROL, ROCK MULCH	LPSM										ALL		
	A0300	15720-0000	STORM WATER POLLUTION PREVENTION PLAN	SQYD												
	A0320	15802-0000	WATERING FOR DUST CONTROL	LPSM									20	20		At direction of CO (Sinkholes)
	A0340	20101-0000	CLEARING AND GRUBBING	ACRE										ALL		
	A0360	20220-1000	REMOVAL, INDIVIDUAL TREE	EACH						37.4			1.1	38.5		
	A0380	20301-0700	REMOVAL OF DELINEATOR	EACH					100				5	105		
	A0400	20301-1100	REMOVAL OF GATE	EACH							416			416		
	A0420	20301-1200	REMOVAL OF HEADWALL	EACH					3					3		Road Closure Gates
	A0440	20301-1400	REMOVAL OF INLET	EACH		5								5		
	A0460	20301-2300	REMOVAL OF SIGN/MARKER	EACH		11								11		
A008	A0470	20301-2800	REMOVAL OF STRUCTURES AND OBSTRUCTIONS 	EACH				180			63			63		
	A0480	20302-1200	REMOVAL OF GUARDRAIL	LNFT				4,697					20	200		Removal of concrete "deadmen"
	A0500	20302-2100	REMOVAL OF PIPE CULVERT	LNFT		272							235	4,932		
	A0520	20303-1600	REMOVAL OF PAVEMENT, ASPHALT	SQYD			50,614						13	285		
	A0540	20303-3200	REMOVAL OF SIDEWALK, CONCRETE	SQYD									1,586	52,200		
A008	A0560	20304-1000	REMOVAL OF STRUCTURES AND OBSTRUCTIONS 	LPSM					22				3	25		
	A0580	20401-0000	ROADWAY EXCAVATION	CUYD	6,607								ALL	ALL		Removal of concrete "deadmen"
	A0600	20402-0000	SUBEXCAVATION	CUYD						236			657	7,500		
	A0620	20421-0000	ROCK EXCAVATION	CUYD									250	250		
	A0640	20425-1000	DITCH, EXCAVATION	LNFT		864				178			17	195		
	A0660	20441-0000	WASTE	CUYD	4,549								36	900		
													451	5,000		




AMENDMENT A008

 01/10/20 Pay Item Change

SUMMARY OF QUANTITIES

STATE	PROJECT	SHEET
CA	CA FLAP NEV 40(1) DONNER PASS	82

A M E N D	Line Item No.	Pay Item Number	Pay Item Description	Unit	Sheet and Description										Estimated Quantities	Remarks and/or Determination of Estimated Quantity
					B5	B6 - B7	B8 - B9	B10	B11	B12 - B13	B14 - B16	B17				
					GRADING SUMMARY	DRAINAGE SUMMARY	SURFACING SUMMARY	GUARDRAIL SUMMARY	REMOVAL SUMMARY	TABULATION OF QUANTITIES	PERMANENT SIGN SUMMARY	PERMANENT PAVEMENT MARKING SUMMARY	Allowance	Bld Schedule		
	A0680	20442-0000	SLOPE SCALING	CUYD												
	A0700	20501-0000	CONTROLLED BLAST HOLE	LNFT						19			1	20		
	A0720	20702-1000	GEOTEXTILE FILTER, CLASS 2, TYPE E	SQYD						2,630			270	2,900		
	A0740	25101-2200	PLACED RIPRAP, METHOD B, CLASS 2	CUYD		12							200	200		As directed by CO (Sinkholes)
	A0760	25101-2400	PLACED RIPRAP, METHOD B, CLASS 4	CUYD		3				32			4	48		
	A0780	25210-0000	ROCKERY	SQFT									1	4		
	A0800	25501-1000	MECHANICALLY STABILIZED EARTH WALL, WELDED WIRE FACE	SQFT						603			62	665		
	A0820	26002-0000	ROCK DOWEL	LNFT						7,505			295	7,800		
	A0840	26005-0000	SHEAR PIN	EACH						54			6	60		
	A0860	30202-2000	ROADWAY AGGREGATE, METHOD 2	TON						20				20		At direction of CO
	A0880	30301-2000	SHOULDER RECONDITIONING	MILE			11,612						588	12,200		
	A0900	30302-1000	DITCH RECONDITIONING	LNFT			10,491							10,491		
	A0920	30401-5000	FULL DEPTH RECLAMATION, METHOD 2	MILE		677							23	700		
	A0960	40101-5600	ASPHALT CONCRETE PAVEMENT, GYRATORY MIX, 1/2-INCH OR 3/4-INCH NOMINAL MAXIMUM SIZE AGGREGATE, 0.3 TO <3 MILLION ESAL	TON			2,894						0.206	3,100		
	A0980	40105-3000	ANTISTRIP ADDITIVE, TYPE 3	TON			19,202						798	20,000		
	A1020	40303-0100	ASPHALT CONCRETE PAVEMENT, TYPE 1, WEDGE AND LEVELING COURSE	TON			192						8	200		
	A1040	40601-0000	FOG SEAL	TON			4,038						112	4,150		
	A1060	41102-0000	PRIME COAT	SQYD			51						4	55		
	A1080	41105-0000	BLOTTER	TON			62,467						3,033	65,500		
	A1100	41201-0000	TACK COAT	TON			177						13	190		
	A1120	50207-0000	CONCRETE PAVEMENT RESTORATION, CRACKING AND SEATING PAVEMENT	SQYD			99						11	110		
	A1140	55401-1000	REINFORCING STEEL	LB			49,351						1,649	51,000		
	A1160	56603-0000	REINFORCED SHOTCRETE	SQYD		178								178		
	A1180	60101-0000	CONCRETE	CUYD						834			66	900		
	A1200	60103-0140	CONCRETE, HEADWALL FOR 24-INCH PIPE CULVERT	EACH		2.8							0.2	3.0		
	A1220	60201-0400	12-INCH PIPE CULVERT	LNFT		1								1		
	A1240	60201-0500	15-INCH PIPE CULVERT	LNFT		30							5	35		
	A1260	60201-0600	18-INCH PIPE CULVERT	LNFT		17							3	20		
						270							15	285		

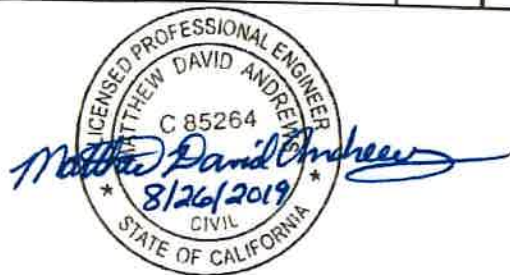

Q:\2015 Projects\15-030.02 Donner Pass Preliminary Design - CULVERT CA FLAP NEV 40(1) Roadway\400_Sheets\B-Summ\Spradsheet\TAB(DONN)CA40_SQO.xlsm]Sheet (2)

SUMMARY OF QUANTITIES

STATE	PROJECT	SHEET NUMBER
CA	CA FLAP NEV 40(1) CONNER PASS	B3

A M E N D	Line Item No.	Pay Item Number	Pay Item Description	Unit	Sheet and Description										Estimated Quantities	Remarks and/or Determination of Estimated Quantity
					B5	B6 - B7	B8 - B9	B10	B11	B12 - B13	B14 - B16	B17				
					GRADING SUMMARY	DRAINAGE SUMMARY	SURFACING SUMMARY	GUARDRAIL SUMMARY	REMOVAL SUMMARY	TABULATION OF QUANTITIES	PERMANENT SIGN SUMMARY	PERMANENT PAVEMENT MARKING SUMMARY	Allowance	Bid Schedule		
	A1280	60201-0800	24-INCH PIPE CULVERT	LNFT		235										
	A1300	60201-0900	30-INCH PIPE CULVERT	LNFT		48							10	245		
	A1320	60201-1100	42-INCH PIPE CULVERT	LNFT		55							2	50		
	A1340	60201-1200	48-INCH PIPE CULVERT	LNFT		44							5	60		
	A1360	60210-0500	END SECTION FOR 15-INCH PIPE CULVERT	EACH		2							1	45		
	A1380	60210-0600	END SECTION FOR 18-INCH PIPE CULVERT	EACH		1								2		
	A1400	60210-0800	END SECTION FOR 24-INCH PIPE CULVERT	EACH		7								1		
	A1420	60210-0900	END SECTION FOR 30-INCH PIPE CULVERT	EACH		2								7		
	A1440	60210-1100	END SECTION FOR 42-INCH PIPE CULVERT	EACH		2								2		
	A1460	60401-0000	MANHOLE	EACH		2								2		
	A1480	60403-1200	INLET, FLH TYPE 5A	EACH		23								2		
	A1500	60403-2300	INLET, FLH TYPE 7B	EACH		3								23		
	A1520	60405-0000	MANHOLE ADJUSTMENT	EACH										3		
	A1540	60901-2100	CURB, ASPHALT, 4-INCH DEPTH	LNFT					57				3	60		
	A1560	60905-1000	GUTTER, CONCRETE	LNFT						7,045			355	7,400		
	A1580	61108-4000	ADJUST VALVE BOX	EACH						138			7	145		
	A1600	61505-1000	ACCESSIBILITY RAMP, CONCRETE	EACH					42				3	45		
	A1620	61701-4500	GUARDRAIL SYSTEM MGS, TYPE 2, CLASS A STEEL POSTS	LNFT						1				1		
	A1640	61702-0600	TERMINAL SECTION, TYPE FLARED	EACH				4,225					125	4,350		
	A1660	61702-0800	TERMINAL SECTION TYPE TANGENT	EACH				27						27		
	A1680	61702-1200	TERMINAL SECTION, TYPE LST	EACH				4						4		
	A1700	61707-1000	STRUCTURE TRANSITION RAILING, G4 SYSTEM	LNFT				1						1		
	A1720	61707-4000	STRUCTURE TRANSITION RAILING, MGS SYSTEM	LNFT				27						27		
	A1740	61801-0000	CONCRETE BARRIER	LNFT				81						81		
	A1760	61902-0000	GATE	EACH				70					5	75		
	A1780	61902-1600	GATE, METAL, 20 FEET WIDTH	EACH						1				1		
	A1800	62201-0200	DUMP TRUCK, 8 CUBIC YARD MINIMUM CAPACITY	HOUR						2				2		
	A1820	62201-0550	BACKHOE LOADER, 6 CUBIC FOOT MINIMUM RATED CAPACITY BUCKET, 24-INCH WIDTH	HOUR									80	80		
	A1840	62201-0950	WHEEL LOADER, 3 CUBIC YARD MINIMUM RATED CAPACITY	HOUR									80	80		
	A1860	62201-1300	BULLDOZER, 160HP MINIMUM FLYWHEEL POWER	HOUR									80	80		
	A1880	62201-2850	MOTOR GRADER, 12 FOOT MINIMUM BLADE	HOUR									80	80		
	A1900	62201-3350	HYDRAULIC EXCAVATOR, 1 CUBIC YARD MINIMUM CAPACITY	HOUR									80	80		



Q:\2015 Projects\15-030 02 Donner Pass Preliminary Design - CFI\HD\CA FLAP NEV 40(1)\Roadway\CADD_Sheets\B-Summ\Spreadsheet\TAB(DONNY)Ca40_SQ40.kim[Sheet 4]

SUMMARY OF QUANTITIES														STATE	PROJECT	SHEET NUMBER
														CA	CA FLAP NEV 40(1) DONNER PASS	B4
A M E N D	Line Item No.	Pay Item Number	Pay Item Description	Unit	Sheet and Description									Estimated Quantities	Remarks and/or Determination of Estimated Quantity	
					B5	B6 - B7	B8 - B9	B10	B11	B12 - B13	B14 - B16	B17				
					GRADING SUMMARY	DRAINAGE SUMMARY	SURFACING SUMMARY	GUARDRAIL SUMMARY	REMOVAL SUMMARY	TABULATION OF QUANTITIES	PERMANENT SIGN SUMMARY	PERMANENT PAVEMENT MARKING SUMMARY	Allowance	Bid Schedule		
	A1920	62301-0000	GENERAL LABOR	HOUR									80	80		
	A1940	62302-1000	SPECIAL LABOR, HIRED TECHNICAL SERVICES	HOUR									80	80		
	A1960	62302-1100	SPECIAL LABOR, HIRED SURVEY SERVICES	HOUR									80	80		
	A1980	62401-0300	FURNISHING AND PLACING TOPSOIL, 4-INCH DEPTH	SQYD	13,288								712	14,000		
	A2000	62510-2000	SEEDING, HYDRAULIC METHOD	ACRE						8.1			0.2	8.3		
	A2020	62515-2000	MULCHING, HYDRAULIC METHOD	ACRE						8.1			0.2	8.3		
	A2040	63301-0000	SIGN SYSTEM	EACH							97			97		
	A2060	63309-1000	DELINEATOR, TYPE SNOW POLE	EACH							355			355		
	A2080	63316-1000	REMOVE AND RESET SIGN	EACH							2			2		
	A2100	63318-1000	SNOW POLE HOLDER	EACH							115			115		
	A2120	63402-2300	PAVEMENT MARKINGS, TYPE L, SOLID	MILE								25.8	0.2	26.0		
	A2140	63403-0400	PAVEMENT MARKINGS, TYPE D	SQFT								492	8	500		
	A2160	63405-1350	PAVEMENT MARKINGS, TYPE D, STRAIGHT ARROW	EACH								35		35		
	A2180	63405-1650	PAVEMENT MARKINGS, TYPE D, ACCESSIBILITY SYMBOL	EACH								2		2		
	A2200	63407-0200	RECESSED PAVEMENT MARKER, BI-DIRECTIONAL REFLECTIVE	EACH								1,410	40	1,450		
	A2220	63501-0000	TEMPORARY TRAFFIC CONTROL	LPSM										ALL		
A008	A2225	63713-0000	FIELD OFFICE SERVICES ⚠	MO										18		
A008	A2230	64502-0000	LOCATE UTILITIES ⚠	EACH										40		



AMENDMENT A008
 01/10/20 Pay Item Change

3/21/2019 1:01:19 PM Q:\2015 Projects\15-030.02 Donner Pass Preliminary Design - CFLHD\CA FLAP NEV 40(1)\Roadway\CADD_Sheets\B-Summ\TAB(DONN)CA40_Grading Summary.dgn User: mcarlson

STATE	PROJECT	SHEET NUMBER
CA	CA FLAP NEV 40(1) DONNER PASS	B5

GRADING SUMMARY				
Station to Station	Roadway Excavation For info only	Pay Item 20401-0000	Embankment For info only	Pay Item 20441-0000
	ROADWAY PRISM	ROADWAY EXCAVATION	ROADWAY PRISM	WASTE
	BCY	CUYD	CCY	CUYD
104+50 - 108+00	72	72	2	70
108+00 - 120+00	316	316	120	196
120+00 - 133+00	387	387	64	323
133+00 - 147+00	419	419	21	398
147+00 - 160+00	472	472	10	462
160+00 - 173+00	359	359	63	296
173+00 - 182+00	238	238	110	128
182+00 - 196+00	321	321	126	195
196+00 - 210+00	439	439	103	336
210+00 - 224+00	306	306	105	201
224+00 - 238+00	409	409	55	354
238+00 - 252+00	326	326	41	285
252+00 - 266+00	307	307	38	269
266+00 - 280+00	321	321	50	271
280+00 - 294+00	211	211	56	155
294+00 - 308+00	183	183	72	111
308+00 - 318+00	90	90	218	0
318+00 - 326+00	93	93	40	53
326+00 - 336+00	76	76	62	14
336+00 - 350+00	137	137	47	90
350+00 - 360+00	131	131	60	71
360+00 - 372+00	120	120	132	0
372+00 - 386+00	154	154	106	48
386+00 - 400+00	242	242	195	47
400+00 - 413+00	80	80	79	1
413+00 - 420+00	56	56	49	7
420+00 - 434+00	123	123	49	0
434+00 - 442+50	219	219	51	168
TOTALS	6,607	6,607	2,124	4,548

- Notes:
1. Estimated quantities calculated using volumes adjusted for shrink/swell. Value assumed to be 1.
 2. The quantities shown herein are approximations. Payment will be made for the actual quantities of work performed.
 3. The quantities shown herein represent estimated volumes to construct the roadway prism only. See the MSE Wall Summary, Rockery Summary and Rock Cut Summary for pay items and quantities associated with MSE walls, rockery and rock cuts.
 4. BCY = Bank cubic yard - one cubic yard of material as it lies in the natural state.
CCY = Compacted cubic yard - one cubic yard of material after it has been compacted to specification density.

TOPSOIL SUMMARY	
Item Number	62401-0300
Station to Station	FURNISHING AND PLACING TOPSOIL, 4-INCH DEPTH
	SCYD
104+50 - 108+00	95
108+00 - 120+00	796
120+00 - 133+00	685
133+00 - 147+00	526
147+00 - 160+00	492
160+00 - 173+00	1,072
173+00 - 182+00	597
182+00 - 196+00	864
196+00 - 210+00	913
210+00 - 224+00	961
224+00 - 238+00	671
238+00 - 252+00	671
252+00 - 266+00	526
266+00 - 280+00	768
280+00 - 294+00	
294+00 - 308+00	
308+00 - 318+00	
318+00 - 326+00	
326+00 - 336+00	
336+00 - 350+00	
350+00 - 360+00	
360+00 - 372+00	
372+00 - 386+00	
386+00 - 400+00	
400+00 - 413+00	1,121
413+00 - 420+00	626
420+00 - 434+00	1,155
434+00 - 442+50	750
TOTALS	13,288

- Notes:
1. No conservable topsoil was assumed to be stripped in cuts or under fills. All topsoil is assumed as imported.
 2. No topsoil will be placed between 289+00 to 395+00 due to existing rock fill.



U.S. DEPARTMENT OF TRANSPORTATION
FEDERAL HIGHWAY ADMINISTRATION
CENTRAL FEDERAL LANDS HIGHWAY DIVISION

GRADING SUMMARY

Item Number			DRAINAGE SUMMARY																
Station	Side	Skew (deg)	SURVEY AND STAKING, DRAINAGE STRUCTURE	REMOVAL OF HEADWALL	REMOVAL OF INLET	REMOVAL OF PIPE CULVERT	DITCH, EXCAVATION	PLACED RIPRAP, METHOD B, CLASS 2	PLACED RIPRAP, METHOD B, CLASS 4	DITCH RECONDITIONING	REINFORCING STEEL	CONCRETE	CONCRETE, HEADWALL FOR 24-INCH PIPE CULVERT	12-INCH PIPE CULVERT	15-INCH PIPE CULVERT	18-INCH PIPE CULVERT	24-INCH PIPE CULVERT	30-INCH PIPE CULVERT	42-INCH PIPE CULVERT
			EACH	EACH	EACH	LNFT	LNFT	CUYD	CUYD	LNFT	LB	CUYD	EACH	LNFT	LNFT	LNFT	LNFT	LNFT	LNFT
128+28		9	1			75			3										
128+92	LT					40													55
129+41	LT		1																
129+90	LT					43													
136+75	LT															136			
149+57	LT		1																
149+94	LT					15												2	
174+83	LT			1												90			
184+33	LT				1	1										5			
185+66	LT			1		3													
187+96	LT				1														
191+29	LT				1	2										1			
192+66																			
193+80	LT				1	3											30		
196+87	LT			1		2													
200+21	LT				1	3													
202+02	LT			1															
203+44	LT				1														
205+36	LT			1												6			
207+04	LT				1											8			
214+42	LT				1												7		
237+12	LT			1												1			
238+11	LT				1												1		
239+92	LT				1												3		
251+43	LT				1											6			
280+82	LT			1												7			
282+55	LT			1												5			
283+55	LT			1														4	
283+85	LT		1			30								30		3			
287+96	LT			1	1						178	2.8							
292+41			1	2		55													
310+82			1	1												2			
312+00				1															
319+78	LT						238						1				35		
322+63	LT							10											
323+03	LT						24												
323+72	LT						80												
324+15		7	1																
341+70	RT						62										40		
342+00	LT						156												
343+55	RT			1															
365+87			1												11				
369+66			1																
374+25	LT																45		
382+67	LT									377							34		
384+04	LT						25												
384+24			1				37												
392+25		3	1																
399+00	RT			2														42	
400+40	LT							2							6		40		
401+77	LT						77												
402+79	LT						107												
420+50	LT						58												
TOTALS			11	5 16	11 13	272	864	12	3	300	178	2.8	1	36	17	270	235	40	55
Notes:			1. The quantities, location, and skews shown are approximate and are subject to field adjustment.																

1:01:24 PM Q:\2015 Projects\15-030.02 Donner Pass Preliminary Design - CFLHD\CA FLAP NEV 40(1)\Roadway\CADD_Sheets\B-Summary\TAB(DOWN)\CA40_Drainage Summary.dgn User: mcarlson

DRAINAGE SUMMARY													
Item Number			60201-1200	60210-0500	60210-0600	60210-0800	60210-0900	60210-1100	60401-0000	60403-1200	60403-2300	NO PAY	
Station	Side	Skew (deg)	48-INCH PIPE CULVERT	END SECTION FOR 15-INCH PIPE CULVERT	END SECTION FOR 18-INCH PIPE CULVERT	END SECTION FOR 24-INCH PIPE CULVERT	END SECTION FOR 30-INCH PIPE CULVERT	END SECTION FOR 42-INCH PIPE CULVERT	MANHOLE	INLET, FLH TYPE 5A	INLET, FLH TYPE 7B	GEOTEXTILE FILTER, CLASS 1, TYPE E (NON-WOVEN)	Remarks
			LNFT	EACH	EACH	EACH	EACH	EACH	EACH	EACH	EACH	EACH	
128+28		9						2					
128+92	LT											10	Remove and replace existing culvert.
129+41	LT												Remove existing approach road culvert, LT.
129+90	LT												Install approach road culvert 18" HDPE, LT.
136+75	LT							1					Remove existing approach road culvert, Lt.
149+57	LT												Extend existing 30" CMP, install end section, Lt.
149+94	LT									1			Install inlet and approach road culvert, Lt.
174+83	LT				1								Remove existing approach road culvert, Lt.
184+33	LT												Extend existing 18" CMP, install end section, Lt.
185+66	LT									1			Remove and replace existing inlet, Lt. Inlet in bike lane
187+96	LT									1			Install inlet, Lt. Inlet in bike lane
191+29	LT									1			Remove and replace existing inlet, Lt. Inlet in bike lane
192+66										1			Remove and replace existing inlet, Lt. Inlet in bike lane
193+80	LT					1				1			Install 24" HDPE with inlet, Lt. and end section, Rt. Inlet in bike lane
196+87	LT									1			Remove and replace existing inlet, Lt. Inlet in bike lane
200+21	LT									1			Remove headwall and install inlet, Lt. Inlet in bike lane
202+02	LT									1			Remove and replace existing inlet, Lt. Inlet in bike lane
203+44	LT									1			Remove headwall and install inlet, Lt.
205+36	LT									1			Install inlet, Lt.
207+04	LT					1							Extend existing 24" CMP, Lt. Install end section, Lt.
214+42	LT									1			Remove and replace existing inlet, Lt.
237+12	LT									1			Remove and replace existing inlet, Lt.
238+11	LT									1			Remove and replace existing inlet, Lt.
239+92	LT									1			Remove and replace existing inlet, Lt.
251+43	LT									1			Remove and replace existing inlet, Lt.
280+82	LT									1			Remove and replace existing inlet, Lt.
282+55	LT										2		Remove headwall. Extend existing 30" CMP install (2) inlets, Lt.
283+55	LT									1			Remove headwall. Extend existing 18" CMP install inlet, Lt.
283+85	LT												Remove and replace approach road culvert, Lt.
287+96	LT												Install wingwall, Lt.
292+41			44						2	1			Install inlet, Lt. Extend existing pipe, Lt.
310+82						1							Remove and replace section of existing culvert with (2) manholes.
319+78	LT												Install 24" HDPE with headwall, Lt.
322+63	LT												Grade Ditch
323+03	LT											33	Rundown
323+72	LT												Grade Ditch
324+15		7				1				1			Grade Ditch
341+70	RT												Install 24" HDPE with inlet, Lt. and end section, Rt.
342+00	LT												Grade Ditch
343+55	RT			1									Grade Ditch
365+87							1						Extend 15" existing CMP with end section, Rt.
369+66							1			1			Install 24" HDPE with inlet, Lt. and end section, Rt.
374+25	LT									1			Install 24" HDPE with inlet, Lt. end section, Rt.
382+67	LT												Recondition ditch from Sta 372+39 to 376+16
384+04	LT												Grade Ditch
384+24								1					Grade Ditch
392+25		3					1				1		Install 30" HDPE with inlet, Lt. and end section, Rt.
399+00	RT			1						1			Install 24" HDPE with inlet, Lt. and end section, Rt.
400+40	LT											9	Remove headwall, extend 15" CMP with end section, Rt.
401+77	LT												Grade Ditch
402+79	LT												Grade Ditch
420+50	LT												Grade Ditch
TOTALS			44	1	0	5	5	0	1	22	2	52	Recondition ditch from Sta 419+00 to 422+00

Notes:

Notes:

1. The quantities, location, and skews shown are approximate and are subject to field adjustment. Do not order culvert pipe or appurtenances until the actual quantities are approved in the field by the Contracting Officer.
2. See C-sheets for pipe material type
3. It is assumed that structural excavation and structural backfill are included in the cost of all pipes and drainage structures.

STATE	PROJECT	SHEET NUMBER
CA	CA FLAP NEV 40(1) DONNER PASS	87



U.S. DEPARTMENT OF TRANSPORTATION
FEDERAL HIGHWAY ADMINISTRATION
CENTRAL FEDERAL LANDS HIGHWAY DIVISION

DRAINAGE SUMMARY

Sheet 2 of 2

4/1/2019

6:00:17 AM

Q:\2015 Projects\15-030.02 Donner Pass Preliminary Design - C&D\CA FLAP NEV 40(1)\Roadway\CADD_Sheets\B-Summ\TAB(DOWN)\CA40_Surfacing Summary.dgn

User: mcarlson

SURFACING SUMMARY											
Item Number	20303-1600	30202-2000	30301-2000	30401-5000	40101-5600	40303-0100	40105-3000	40601-0000	41102-0000	41201-0000	50207-0000
Station to Station	REMOVAL OF PAVEMENT, ASPHALT	ROADWAY AGGREGATE, METHOD 2	SHOULDER RECONDITIONING	FULL DEPTH RECLAMATION, METHOD 2	ASPHALT CONCRETE PAVEMENT, GYRATORY MIX, 1/2-INCH OR 3/4-INCH NOMINAL MAXIMUM SIZE AGGREGATE, 0.3 TO <3 MILLION ESAL	ASPHALT CONCRETE PAVEMENT, TYPE 1, WEDGE AND LEVELING COURSE	ANTISTRIP ADDITIVE, TYPE 3	FOG SEAL	PRIME COAT	TACK COAT	CONCRETE PAVEMENT RESTORATION, CRACKING AND SEATING PAVEMENT
	SQYD	TON	MILE	MILE	TON	TON	TON	TON	SQYD	TON	SQYD
Donner Pass Road											
104+50 - 111+10		29	0.250	0.125	354		3.5	0.9	2167	0.9	
111+10 - 231+20	29282	5498	4.549		6346	3440	63	17		51	29282
135+55 - 143+25		33	0.292	0.146	353		3.5	0.9	2163	0.9	
231+20 - 280+90	12789	2282	1.883		2723	598	27.2	7.2		21.6	12789
280+90 - 304+00	7280	840	0.875		1280		12.8	3.4	7833	3.4	7280
304+00 - 338+00		148	0.663 0.644	0.644	1646		16.5	4.3	10079	4.3	
338+00 - 442+50		454	1.979	1.979	5453		54.5	14.3	33385	14.3	
Approach Roads											
109+00 Lt.		82			51		0.51	0.135	314	0.135	
111+10 Rt.		2			1		0.01	0.004	9	0.004	
115+70 Lt.		25			15		0.15	0.040	94	0.040	
116+65 Rt.		12			8		0.08	0.020	46	0.020	
116+75 Lt.		5			3		0.03	0.008	19	0.008	
119+10 Rt.		3			2		0.02	0.004	10	0.004	
119+40 Lt.		8			5		0.05	0.013	30	0.013	
119+60 Rt.		3			2		0.02	0.005	13	0.005	
120+00 Lt.		48			30		0.30	0.079	185	0.079	
120+60 Rt.		2			1		0.01	0.004	8	0.004	
123+37 Rt.		6			4		0.04	0.011	25	0.011	
123+95 Rt.		3			2		0.02	0.005	11	0.005	
124+05 Lt.		10			6		0.06	0.016	37	0.016	
125+10 Lt.		46			29		0.29	0.076	177	0.076	
126+35 Lt.		39			24		0.24	0.064	149	0.064	
126+60 Rt.		93			58		0.58	0.153	357	0.153	
127+45 Lt.		4			2		0.02	0.006	15	0.006	
128+93 Lt.		16			10		0.10	0.027	63	0.027	
129+50 Rt.		10			6		0.06	0.016	37	0.016	
129+80 Lt.		11			1		0.01	0.002	5	0.002	
130+47 Lt.		11			1		0.01	0.003	6	0.003	
132+00 Lt.		25			7		0.07	0.019	44	0.019	
133+30 Lt.		8			2		0.02	0.004	10	0.004	
134+05 Lt.		9			3		0.03	0.008	18	0.008	
137+90 Rt.		82			51		0.51	0.135	314	0.135	
137+93 Lt.		4			2		0.02	0.006	14	0.006	
139+55 Rt.		22			14		0.14	0.036	85	0.036	
140+55 Rt.		43			27		0.27	0.071	165	0.071	
140+63 Lt.		4			2		0.02	0.006	14	0.006	
142+90 Rt.		3			2		0.02	0.005	13	0.005	
143+95 Rt.		2			1		0.01	0.003	7	0.003	
145+00 Rt.		6			3		0.03	0.009	21	0.009	
145+40 Lt.		7			4		0.04	0.011	27	0.011	
146+65 Rt.		18			11		0.11	0.029	68	0.029	
148+57 Rt.		3			2		0.02	0.005	11	0.005	
149+60 Lt.		17			11		0.11	0.028	65	0.028	
150+60 Rt.		30			19		0.19	0.050	116	0.050	
150+75 Lt.		6			4		0.04	0.009	22	0.009	
151+80 Lt.		9			6		0.06	0.016	36	0.016	
153+30 Lt.		2			2		0.02	0.004	10	0.004	
153+50 Rt.		21			5		0.05	0.012	28	0.012	
154+55 Lt.		7			2		0.02	0.006	14	0.006	
155+00 Rt.		3			2		0.02	0.006	13	0.006	
155+25 Lt.		5			3		0.03	0.008	19	0.008	

STATE	PROJECT	SHEET NUMBER
CA	CA FLAP NEV 40(1) DONNER PASS	88

085264
Matthew David Anderson
4/1/2019
STATE OF CALIF.

Values used for estimating purposes:
Roadway aggregate . . . 139 lb/ft3
Asphalt concrete pavement . . . 145.2 lb/ft3
Antistrip . . . 1 % of weight of mix
Fog seal . . . 0.1 gal/yd2 (233 gal/ton)
Asphalt binder . . . 6 % of weight of mix
Prime coat . . . 0.27 gal/yd2 (233 gal/ton)
Tack coat . . . 0.1 gal/yd2 (233 gal/ton)
Blotter . . . 14.75 lb/yd2 , assume 20% of area

U.S. DEPARTMENT OF TRANSPORTATION
FEDERAL HIGHWAY ADMINISTRATION
CENTRAL FEDERAL LANDS HIGHWAY DIVISION

SURFACING SUMMARY

Sheet 1 of 2

SURFACING SUMMARY											
Item Number	20303-1600	30202-2000	30301-2000	30401-5000	40101-5600	40303-0100	40105-3000	40601-0000	41102-0000	41201-0000	50207-0000
Station to Station	REMOVAL OF PAVEMENT, ASPHALT	ROADWAY AGGREGATE, METHOD 2	SHOULDER RECONDITIONING	FULL DEPTH RECLAMATION, METHOD 2	ASPHALT CONCRETE PAVEMENT, GYRATORY MIX, 1/2-INCH OR 3/4-INCH NOMINAL MAXIMUM SIZE AGGREGATE, 0.3 TO <3 MILLION ESAL	ASPHALT CONCRETE PAVEMENT, TYPE 1, WEDGE AND LEVELING COURSE	ANTISTRIP ADDITIVE, TYPE 3	FOG SEAL	PRIME COAT	TACK COAT	CONCRETE PAVEMENT RESTORATION, CRACKING AND SEATING PAVEMENT
	SQYD	TON	MILE	MILE	TON	TON	TON	TON	SQYD	TON	SQYD
156+35 Rt.		13			8						
156+45 Lt.		2			1		0.08	0.021	49	0.021	
158+05 Lt.		4			3		0.01	0.003	6	0.003	
159+00 Rt.		27			17		0.03	0.007	16	0.007	
160+08 Lt.		2			1		0.17	0.044	102	0.044	
160+70 Lt.		5			3		0.01	0.004	8	0.004	
161+70 Lt.		18			11		0.03	0.008	18	0.008	
162+70 Lt.		8			5		0.11	0.029	68	0.029	
170+80 Lt.		4			2		0.05	0.013	30	0.013	
209+70 Lt.		6			4		0.02	0.006	15	0.006	
211+50 Lt.		14			9		0.04	0.010	24	0.010	
221+20 Lt.		25			6		0.09	0.023	53	0.023	
223+90 Lt.		2			1		0.06	0.015	36	0.015	
229+95 Lt.		22			14		0.01	0.004	8	0.004	
249+45 Rt.		12			8		0.14	0.036	85	0.036	
253+11 Rt.		28			17		0.08	0.020	46	0.020	
255+85 Rt.		2			1		0.17	0.046	106	0.046	
257+35 Rt.		9			6		0.01	0.004	8	0.004	
258+95 Rt.		15			2		0.06	0.015	36	0.015	
261+00 Lt.		207			130		0.02	0.006	15	0.006	
261+10 Rt.		8			5		1.30	0.341	796	0.341	
283+50 Lt.		2			1		0.05	0.013	30	0.013	
284+00 Lt.		1			1		0.01	0.003	7	0.003	
286+30 Lt.		11			7		0.01	0.002	5	0.002	
292+00 Lt.		174			109		0.07	0.017	40	0.017	
293+25 Rt.		39			24		1.09	0.287	669	0.287	
294+00 Rt.		11			7		0.24	0.064	150	0.064	
296+79 Lt.		15			2		0.07	0.018	42	0.018	
296+80 Rt.		3			1		0.02	0.005	13	0.005	
304+35 Rt.		77			11		0.01	0.004	9	0.004	
372+20 Lt.		5			3		0.11	0.028	66	0.028	
407+25 Rt.		30			19		0.03	0.008	19	0.008	
423+47 Lt.		11			7		0.19	0.049	113	0.049	
Pullouts							0.07	0.018	43	0.018	
Chain-Up Area					15						
Airway Station		76					0.17	0.04	102	0.044	
Rainbow Bridge Parking Area	1264				138						
School House Pullout		100					2.06	0.54	1264	0.542	
Star Wall Pullout		35									
Snowshed North Pullout		97									
Snowshed South Pullout		200									
Space Wall Pullout		92									
Black Wall Pullout		109									
TOTALS	50,614	11,612	10.494	2.894	19,202	4,038	192	51	62,467	99	49,351

STATE	PROJECT	SHEET NUMBER
CA	CA FLAP NEV 40(1) DONNER PASS	B9

Values used for estimating purposes:
Roadway aggregate 139 lb/ft3
Asphalt concrete pavement 145.2 lb/ft3
Antistrip 1 % of weight of mix
Fog seal 0.1 gal/yd2 (233 gal/ton)
Asphalt binder 6 % of weight of mix
Prime coat 0.27 gal/yd2 (233 gal/ton)
Tack coat 0.1 gal/yd2 (233 gal/ton)
Blotter 14.75 lb/yd2 , assume 20% of area



U.S. DEPARTMENT OF TRANSPORTATION
FEDERAL HIGHWAY ADMINISTRATION
CENTRAL FEDERAL LANDS HIGHWAY DIVISION

SURFACING SUMMARY

Sheet 2 of 2

8:05:54 AM Q:\2015 Projects\15-030.02 Donner Pass Preliminary Design - CFLHD\CA FLAP NEV 40(1)\Roadway\CADD_Sheets\B-Summ\TAB\DONN\CA40_Guardrail Summary.dgn User: dthellung 1/10/2020

STATE	PROJECT	SHEET NUMBER
CA	CA FLAP NEV 40(1) DONNER PASS	B10

Item Number		GUARDRAIL SUMMARY									
		20301-2800	20302-1200	61701-4500	61702-0600	61702-0800	61702-1200	61707-1000	61707-0000	61801-0000	Remarks
Station to Station	Side	REMOVAL OF STRUCTURES AND OBSTRUCTIONS	REMOVAL OF GUARDRAIL	GUARDRAIL SYSTEM MGS, TYPE 2, CLASS A STEEL POSTS	TERMINAL SECTION, TYPE FLARED	TERMINAL SECTION TYPE TANGENT	TERMINAL SECTION, TYPE LST	STRUCTURE TRANSITION RAILING, G4 SYSTEM	STRUCTURE TRANSITION RAILING, MGS SYSTEM	CONCRETE BARRIER	
		EACH	See Note 2	LNFT	LNFT	EACH	EACH	EACH	LNFT	LNFT	
113+00 - 115+36	LT		204	187.50	2					LNFT	
113+20 - 115+72	RT		203	200.00	2						Use 8' posts between Station 114+50 to 115+00 5' shy distance (typ)
162+01 - 163+66	RT			37.50	1						Use 8' posts between Station 114+50 to 115+00 5' shy distance (typ)
162+78 - 164+38	LT			37.50		1					5' shy distance (typ)
309+17 - 313+56	RT		415	387.50	1	1	1	26.875	53.75 50	35	5' shy distance (typ)
314+24 - 316+71	RT		252	212.50	2	1			26.875 25	35	5' shy distance (typ)
322+79 - 324+84	RT		191	150.00	2						2' shy distance (typ)
326+05 - 326+58	RT		46	25.00	2						3' shy distance (typ)
326+16 - 326+74	LT		57	37.50	1						
329+44 - 330+91	LT		158	137.50	1	1					See Note 1
329+54 - 330+38	RT		69	50.00	1						See Note 1
347+20 - 348+25	RT		104	62.50	2						See Note 1
351+03 - 353+11	RT		204	162.50	2						See Note 1
364+93 - 372+24	RT		753	700.00	2						4' shy distance (typ)
372+55 - 375+19	RT		278	237.50	2						1' shy distance (typ)
381+36 - 390+10	RT	105	854	800.00	2						
390+50 - 396+85	RT	75	654	600.00	2						2' shy distance (typ)
410+76 - 413+09	RT		255	200.00	2						1' shy distance (typ)
TOTAL		180	4697	4225.00	27	4	1	26.875	75 80.625	70	2' shy distance (typ)

Notes:

1

Notes:

1. Connect MGS, Type 2, Class A guardrail to existing structure transition railing at the Rainbow Bridge. Contractor to replace connection bolts between Rainbow Bridge barrier and existing structure transition railing at direction of the CO.
2. The quantity for Removal of Guardrail Includes the length of the the terminal sections. All work related to removing guardrail and terminal sections shall be paid for as Removal of Guardrail.
3. See Special 618-A and 618-B, Concrete Barrier Type 60M, for Concrete Barrier details.
4. Install guardrail to match existing shy distance. See cross sections for additional information.
5. Contractor to verify guardrail post locations do not conflict with proposed drainage features or existing utilities prior to installation.
6. 8' posts could not be used at the first two locations due to an existing bridge deck.



AMENDMENT A008
1 01/10/20 Pay Item Change

U.S. DEPARTMENT OF TRANSPORTATION
FEDERAL HIGHWAY ADMINISTRATION
CENTRAL FEDERAL LANDS HIGHWAY DIVISION

GUARDRAIL SUMMARY

STATE	PROJECT	SHEET NUMBER
CA	CA FLAP NEV 40(1) DONNER PASS	B11

REMOVAL SUMMARY						
Item Number	20220-1000	20301-1100	20303-3200	60405-0000	61108-4000	
Station to Station	REMOVAL, INDIVIDUAL TREE (See Note 1)	REMOVAL OF GATE	REMOVAL OF SIDEWALK, CONCRETE	MANHOLE ADJUSTMENT (See Note 2)	ADJUST VALVE BOX (See Note 2)	Remarks
	EACH	EACH	SQYD	EACH	EACH	
Donner Pass Road						
104+50 - 108+00						
108+00 - 120+00	11			1		Sheet C1
120+00 - 133+00	4			3	5	Sheet C2
133+00 - 147+00	4			5	4	Sheet C3
147+00 - 160+00					6	Sheet C4
160+00 - 173+00	15			4	1	Sheet C5
173+00 - 182+00	1			5	4	Sheet C6
182+00 - 196+00				4		Sheet C7
196+00 - 210+00				5		Sheet C8
210+00 - 224+00	3			3	1	Sheet C9
224+00 - 238+00	1			5	6	Sheet C10
238+00 - 252+00	2			2	3	Sheet C11
252+00 - 266+00				4	2	Sheet C12
266+00 - 280+00				1	5	Sheet C13
280+00 - 294+00	2			2		Sheet C14
294+00 - 308+00	2			2	3	Sheet C15
308+00 - 318+00	4	1		2	2	Sheet C16
318+00 - 326+00	4					Sheet C17
326+00 - 336+00	1					Sheet C18
336+00 - 350+00						Sheet C19
350+00 - 360+00				3		Sheet C20
360+00 - 372+00	3			2		Sheet C21
372+00 - 386+00	2					Sheet C22
386+00 - 400+00	7					Sheet C23
400+00 - 413+00				2		Sheet C24
413+00 - 420+00						Sheet C25
420+00 - 434+00	9					Sheet C26
434+00 - 442+50	25	2		1		Sheet C27
				1		Sheet C28
Rainbow Bridge Parking Area						
			22			
TOTALS	100	3	22	57	42	

Notes:
1. Construction of

- Notes:
- Contracting Officer approval required prior to removal.
 - If a manhole or valve box is adjusted more than once, payment will be made for the final adjustment to proper elevation. Interim adjustments are included in the work at no additional cost to the Government.



U.S. DEPARTMENT OF TRANSPORTATION
FEDERAL HIGHWAY ADMINISTRATION
CENTRAL FEDERAL LANDS HIGHWAY DIVISION

REMOVAL SUMMARY

4/11/2019 4:55:34 PM Q:\2015 Projects\15-030.02 Donner Pass Preliminary Design - CFI\HD\CA FLAP NEV 40(1)\Roadway\CADD_Sheets\B-Summ\TAB(DONW)\CA40_Tabulation of Quantities.dgn User: mcarlson

CURB SUMMARY					
Item Number	For info only	25101-2200	60901-2100	50905-1000	
Station to Station	Side	GEOTEXTILE FILTER, CLASS 1, TYPE E (NON-WOVEN)	PLACED RIPRAP, METHOD B, CLASS 2	CURB, ASPHALT, 4-INCH DEPTH	GUTTER, CONCRETE
		SQYD	CUYD	LNFT	
130+32 - 130+65	LT				33
130+75 - 131+75	LT		1	100	
131+77 - 132+22	LT				45
132+25 - 133+15	LT		1	90	
133+16 - 133+44	LT				28
133+45 - 133+87	LT		1	43	
133+87 - 134+20	LT				32
134+20 - 136+75	LT		1	250	
141+50 - 145+10	LT		1	360	
142+50 - 142+75	RT		1	25	
143+05 - 143+85	RT		1	80	
144+05 - 144+75	RT		1	72	
164+37 - 167+00	RT		1	257	
176+50 - 201+75	LT		1	2520	
225+75 - 229+60	LT		1	385	
286+50 - 289+00	LT		1	250	
310+10 - 313+05	RT	2	2	290	
321+75 - 322+55	LT		1	80	
323+05 - 324+58	RT	2	2	150	
324+50 - 326+15	LT		1	165	
366+00 - 368+20	LT		1	205	
368+20 - 369+80	RT	2	2	160	
369+80 - 370+75	LT		1	95	
381+61 - 384+70	RT	2	2	293	
384+70 - 386+20	LT		1	144	
386+20 - 389+25	RT	2	2	289	
389+25 - 390+45	LT		1	115	
392+65 - 394+80	LT		1	207	
395+40 - 396+60	RT	2	2	120	
438+50 - 441+50	LT		1	300	
TOTALS		12	32	7045	138

Notes:

1. Install Gutter, Concrete. See Valley Drain Profile Special Detail 609-3.
2. See Curb Details 609-A for details on Curb, Asphalt, 4-Inch Depth and Placed Riprap, Method B, Class 2. See C Sheets for curb type.

SURVEY AND STAKING SUMMARY					
Item Number	15214-2000	15215-1000	15215-7000	15225-0000	15236-2000
Station to Station	SURVEY AND STAKING, RETAINING WALL	SURVEY AND STAKING, APPROACH ROAD	SURVEY AND STAKING, PARKING AREA	SLOPE, REFERENCE, AND CLEARING AND GRUBBING CONTROL	SURVEY CONTROL, GRADE FINISHING
	LPSM	EACH	EACH	MILE	MILE
104+50 - 442+50	1	77	9	6.4	6.4
TOTALS	ALL	77	9	6.4	6.4

Notes:

1. See MSE Wall Summary and Rockery Summary for retaining wall survey and staking locations.
2. See Surfacing Summary for approach road and parking area survey and staking locations.

SIDEWALK SUMMARY		
Item Number	61505-1000	
Station to Station	ACCESSIBILITY RAMP, CONCRETE	Remarks
	EACH	
Rainbow Bridge Parking Area	1	Parallel curb ramp
TOTALS	1	

STATE	PROJECT	SHEET NUMBER
CA	CA FLAP NEV 40(1) DONNER PASS	B12

CLEARING AND SEEDING SUMMARY				
Item Number	20101-0000	62510-2000	62515-2000	
Station to Station	CLEARING AND GRUBBING	SEEDING, HYDRAULIC METHOD	MULCHING, HYDRAULIC METHOD	Remarks
	ACRE	ACRE	ACRE	
104+50 - 108+00	0.4	0.10	0.1	
108+00 - 120+00	1.4	0.44	0.4	
120+00 - 133+00	1.6	0.44	0.4	
133+00 - 147+00	1.8	0.43	0.4	
147+00 - 160+00	1.4	0.40	0.4	
160+00 - 173+00	1.5	0.52	0.5	
173+00 - 187+00	1.0	0.33	0.3	
182+00 - 196+00	1.5	0.50	0.5	
196+00 - 210+00	1.5	0.51	0.5	
210+00 - 224+00	1.5	0.52	0.5	
224+00 - 238+00	1.4	0.46	0.5	
238+00 - 252+00	1.4	0.46	0.5	
252+00 - 266+00	1.6	0.43	0.4	
266+00 - 280+00	1.4	0.48	0.5	
280+00 - 294+00	1.6			
294+00 - 308+00	1.6			
308+00 - 318+00	1.2			
318+00 - 326+00	1.0			
326+00 - 336+00	0.9			
336+00 - 350+00	1.7			
350+00 - 360+00	1.1			
360+00 - 372+00	1.4			
372+00 - 386+00	1.5			
386+00 - 400+00	1.5	0.30	0.3	
400+00 - 413+00	1.6	0.53	0.5	
413+00 - 420+00	0.8	0.29	0.3	
420+00 - 434+00	1.5	0.56	0.6	
434+00 - 442+50	0.9	0.35	0.4	
TOTAL	37.4 37.7	8.1	8.1	

GATE SUMMARY				
Item Number	61902-0000	61902-1600		
Station to Station	Side	GATE	GATE, METAL, 20 FEET WIDTH	Remarks
		EACH	EACH	
305+45	RT	1		See Note 1
434+90			2	See Note 2
TOTAL		1	2	

Note:

1. Install drop arm road closure gate in accordance to Detail 619-A or equivalent with approval by the CO.
2. Install swing arm road closure gate in accordance to Detail 619-3 or equivalent with approval by the CO.



8:56:24 AM Q:\2015 Projects\15-030.02 Donner Pass Preliminary Design - CFLHD\CA FLAP NEV 40(1)\Roadway\CADD_Sheets\B-Summ\TAB\DONN\CA40_Tabulation of Quantities.dgn User: dtheilung_ 4/2/2019

STATE	PROJECT	SHEET NUMBER
CA	CA FLAP NEV 40(1) DONNER PASS	B13

ROCK CUT SUMMARY								
Item Number		20401-0000	20421-0000	20442-0000	20501-0000	26002-0000	26005-0000	
Station to Station	Side	ROADWAY EXCAVATION	ROCK EXCAVATION	SLOPE SCALING	CONTROLLED BLAST HOLE	ROCK DOWEL	SHEAR PIN (See Note 1)	Remarks
		CUYD	CUYD	CUYD	LNFT	LNFT	EACH	
311+00 - 311+45	LT	16	9	4	138			
311+85 - 311+95	LT	6	2	3	30			
312+30 - 312+36	LT	2	2		30			
314+09 - 314+20	LT	2	2		6			
317+85 - 317+95	LT	2	2		24			
318+27 -	LT	1	1		6			
322+00 - 322+50	LT	25	20	1	150			
324+70 - 324+90	LT	5	3	1.5	40	324+60 22		
324+88 - 325+00	LT	5	3	1	42	±0		
325+00 - 325+25	LT	10	4	4	52	325+18 8		
325+25 - 325+50	LT	12	10		104	±0		
325+50 - 325+65	LT	4	3		32	±0		
365+00 -	LT	2	2		30	±0		
366+35 - 366+90	LT	8	6	1	140			
367+25 - 367+65	LT	14	12		120			
369+90 - 370+30	LT	5	4		80			
370+30 - 370+70	LT	8	7		100			
384+80 - 385+15	LT	4	3	0.5	90	370+40 16		
385+15 - 385+55	LT	5	4		160			
389+30 - 389+80	LT	5	4		150			
392+72 - 393+06	LT	6	5		187			
394+10 - 394+35	LT	16	10	3	39			
394+70 - 394+90	LT	2	2		40			
438+80 - 440+90	LT	70	58		840			
311+00 - 440+90							20	
TOTALS		236	178	49	9450.000	46	20	
		81.300	821.738	40.570			0	

- Notes:
1. Shear pins to be installed at locations directed by the CO based on field conditions.
 2. Rock Dowel locations to be verified by CO prior to installation. If a Rock Bolt is required based on field conditions, install Rock Bolt per detail and pay for work as Rock Dowel.
 3. Removal of rock from the project site paid for as Roadway Excavation. Quantities shown for Rock Excavation and Slope Scaling are in-situ quantities. A swell factor of 1.2 was assumed for Roadway Excavation.

MECHANICALLY STABILIZED EARTH WALL SUMMARY						
Item Number		For Info only	For Info only	25501-1000	For Info only	56603-0000
Station to Station	Side	REINFORCEMENT GEOSYNTHETIC, TYPE 3	STRUCTURE EXCAVATION	MECHANICALLY STABILIZED EARTH WALL, WELDED WIRE FACE	SELECT GRANULAR BACKFILL	REINFORCED SHOTCRETE
		SQYD	CUYD	SQFT	CUYD	SQYD
312+00 - 313+25	RT	833	564	762.80 -1125	558	99.5 -125
368+25 - 369+75	RT	533	277	859.5 -900	321	133.6 -100
374+00 - 374+70	RT	155	140	438 -496	140	79.5 -54
382+25 - 382+75	RT	111	89	144 -300	81	90.4 -32
385+10 - 386+40	RT	1386	712	1059 -1566	789	109.3 -175
386+65 - 387+75	RT	733	453	595.70 -880	438	114.2 -96
393+00 - 394+20	RT	1040	567	690.50 -1000	529	57.3 -120
394+95 - 396+25	RT	606	419	841.76 -1170	455	22.4 -120
TOTAL		5397	3220	5391.26 7505	3312	706.2 -834

- Notes:
1. Reinforcement Geosynthetic, structure excavation and backfill will not be paid for separately but should be included in the cost of Mechanically Stabilized Earth Wall, Welded Wire Face.

Jonathan Blum

REGISTERED PROFESSIONAL ENGINEER
JONATHAN D. BLUM
No. 2312
CALIFORNIA
STATE OF CALIFORNIA

ROCKERY SUMMARY			
Item Number		25210-0000	
Station to Station	Side	ROCKERY	Remarks
		SQFT	
261+22 - 262+36	RT	457.050	
261+68	RT	457.050	
TOTAL		914.100	

- Note:
1. Structure excavation, foundation fill, granular rock back drain, drainage pipe, geotextile and grout will not be paid for separately but will be included in the cost of the rockery.

U.S. DEPARTMENT OF TRANSPORTATION
FEDERAL HIGHWAY ADMINISTRATION
CENTRAL FEDERAL LANDS HIGHWAY DIVISION

TABULATION OF QUANTITIES

Sheet 2 of 2

3:19:01 PM Q:\2015 Projects\15-030.02 Donner Pass Preliminary Design - C:\HD\CA FLAP NEV 40(1)\Roadway\CADD\Sheets\B-Summ\TAB(DOWN)\CA40_Signing Summary.dgn User: mcarlson 4/2/2019

STATE	PROJECT	SHEET NUMBER
CA	CA FLAP NEV 40(1) DONNER PASS	B14

PERMANENT SIGN SUMMARY											
Station	Side	MUTCD Reference	Description	Item Number	20301-0700	20301-2300	63301-0000	63309-1000	63316-1000	63318-1000	Remarks
				Sign Panel	REMOVAL OF DELINEATOR	REMOVAL OF SIGN/MARKER	SIGN SYSTEM	DELINEATOR, TYPE SNOW POLE	REMOVE AND RESET SIGN	SNOW POLE HOLDER	
				In x In	EACH	EACH	EACH	EACH	EACH	EACH	
104+50	LT	R3-2	No Left Turn	24 x 24		1	1				
104+50	RT		BIKE LANE	24 x 18							
			BEGIN	12 x 5			1				
104+70	LT		SACRAMENTO / RENO I-80	72 x 54							CALTRANS SIGN SPEC R81(CA)
105+30	LT		SNOW REMOVAL AREA	36 x 24		1	1				CALTRANS SIGN SPEC R81A(CA)
105+60	RT		SKI AREAS	72 x 48		1	1				CALTRANS SIGN SPEC G77 (WOOD POST - 2 POSTS)
105+90	LT		BIKE LANE	24 x 18		1	1				SPECIAL SIGN LAYOUT (WOOD POST - 1 POST)
			END	8 x 5			1				CALTRANS SIGN SPEC G1-4 (WOOD POST - 2 POSTS)
106+70	RT		HISTORIC ROUTE US 40	24 x 36							CALTRANS SIGN SPEC R81(CA)
107+10	RT		Bicycle	30 x 30		1	1				CALTRANS SIGN SPEC R81B(CA)
			SHARE THE ROAD	30 x 24		1	1				CALTRANS SIGN SPEC S18
108+00	RT		DESTINATION SIGN	72 x 54							CALTRANS SIGN SPEC W79A
			SNOW REMOVAL AREA	36 x 24		1	1				CALTRANS SIGN SPEC W79A
110+40	RT	R2-1	Speed Limit	24 x 30							CALTRANS SIGN SPEC G5 (WOOD POST - 2 POSTS)
			SPEED ENFORCED BY RADAR	24 x 30		1	1				SPECIAL SIGN LAYOUT
112+90	RT	W11-2	Pedestrian	30 x 30							25 MPH 35 MPH
		W7-3AP	Next XX Miles (plaque)	24 x 18		1	1				CALTRANS SIGN SPEC R48
119+70	LT		POMA LN	36 x 6							
			DONNER PASS LN	36 x 6		1	1				NEXT 1 MILES
119+80	LT	R1-1	Stop	30 x 30							NEVADA COUNTY STREET NAME SIGN re-use existing
121+50	RT		SODA SPRINGS	54 x 24		1	1				NEVADA COUNTY STREET NAME SIGN re-use existing
123+60	LT		BIKE LANE	24 x 18							
		R8-3	NO PARKING	24 x 24			1				CALTRANS SIGN SPEC G9-2 (WOOD POST - 2 POSTS)
124+15	RT	R2-1	Speed Limit	24 x 30							CALTRANS SIGN SPEC R81(CA)
124+80	LT		LOLA MONTEZ LN	36 x 6		1	1				
			DONNER PASS LN	36 x 6		1	1				25 MPH 35 MPH
124+85	LT	R1-1	Stop	30 x 30							NEVADA COUNT STREET NAME SIGN re-use existing
127+70	LT	W2-2R	Side Road Right	30 x 30		1	1				NEVADA COUNT STREET NAME SIGN re-use existing
128+30	LT	R2-1	Speed Limit	24 x 30							
134+60	RT		SERENE LAKES	36 x 12		1	1				
134+80	RT		BIKE LANE	24 x 18							25 MPH 35 MPH
		R8-3	NO PARKING	24 x 24			1				CALTRANS SIGN SPEC G8-1
136+50	RT	W10-2R	Grade Crossing Right and Intersection	36 x 36							CALTRANS SIGN SPEC R81(CA)
139+20	LT		SKI AREAS	72 x 48		1	1				
139+60			SODA SPRINGS RD	48 x 12		1	1				
			SODA SPRINGS RD	48 x 12		1	1				CALTRANS SIGN SPEC G8-13 MODIFIED (WOOD POST - 2 POSTS)
139+75	RT		SODA SPRINGS RD	36 x 6		1	1				CALTRANS SIGN SPEC G8-1 MOUNT TO MAST
			DONNER PASS LN	36 x 6		1	1				CALTRANS SIGN SPEC G8-1 MOUNT TO MAST
		R1-1	STOP	30 x 30							NEVADA COUNTY STREET NAME SIGN re-use existing
143+50	LT	W10-2L	Grade Crossing Left and Intersection	36 x 36							NEVADA COUNTY STREET NAME SIGN re-use existing
144+70	RT	R2-1	Speed Limit	24 x 30		1	1				
144+80	LT		BIKE LANE	24 x 18							25 MPH 35 MPH
		R8-3	NO PARKING	24 x 24			1				CALTRANS SIGN SPEC R81(CA)
151+10	LT	R2-1	Speed Limit	24 x 30							
165+20	RT		BIKE LANE	24 x 18		1	1				25 MPH 35 MPH
		R8-3	NO PARKING	24 x 24			1				CALTRANS SIGN SPEC R81(CA)
168+50	LT	R2-1	Speed Limit	24 x 30							
			SPEED ENFORCED BY RADAR	24 x 30		1	1				35 MPH
168+80	RT	R2-1	Speed Limit	24 x 30							CALTRANS SIGN SPEC R48
			CHAIN INSTALLATION ONLY	36 x 24		1	1				35 MPH
169+80	RT		CHAIN INSTALLATION ONLY	36 x 24							CALTRANS SIGN SPEC R74 MODIFIED
						1	1				CALTRANS SIGN SPEC R74 MODIFIED

- Notes:
1. Use galvanized metal square tubular steel posts in accordance with FP-14 718.04(B)(2) and The Nevada County Standard Sign and Post Installation Detail for all signs unless otherwise noted as wood post in remarks above.
 2. Delineator, Type Snow Pole to be 1" OD schedule 40 pipe or approved equivalent.



U.S. DEPARTMENT OF TRANSPORTATION
FEDERAL HIGHWAY ADMINISTRATION
CENTRAL FEDERAL LANDS HIGHWAY DIVISION

PERMANENT SIGN SUMMARY
Sheet 1 of 3

3:19:04 PM Q:\2015 Projects\15-030.02 Donner Pass Preliminary Design - CFLHD\CA FLAP NEV 40(1)\Roadway\CADD_Sheets\B-Summary\TAB(DOWN)\CA40_Signing_Summary.dgn User: mcarlson_

STATE	PROJECT	SHEET NUMBER
CA	CA FLAP NEV 40(1) DONNER PASS	B15

PERMANENT SIGN SUMMARY											
Station	Side	MUTCD Reference	Description	Item Number	20301-0700	20301-2300	63301-0000	63309-1000	63316-1000	63318-1000	Remarks
				Sign Panel	REMOVAL OF DELINEATOR	REMOVAL OF SIGN/MARKER	SIGN SYSTEM	DELINEATOR, TYPE SNOW POLE	REMOVE AND RESET SIGN	SNOW POLE HOLDER	
				In x In	EACH	EACH	EACH	EACH	EACH	EACH	
169+90	LT	W11-2	Pedestrian	30 x 30		1	1				
		W7-3AP	Next XX Miles (plaque)	24 x 18							
170+80	RT		CHAIN INSTALLATION ONLY	36 x 24		1	1				NEXT 1 MILES
171+70	RT		ICY	30 x 30		1	1				CALTRANS SIGN SPEC R74 MODIFIED
174+70	LT		BIKE LANE	24 x 18			1				CALTRANS W43
		R8-3	NO PARKING	24 x 24			1				CALTRANS SIGN SPEC R81(CA)
189+10	LT		ICY	30 x 30		1	1				
195+00	RT		BIKE LANE	24 x 18			1				CALTRANS W43
		R8-3	NO PARKING	24 x 24			1				CALTRANS SIGN SPEC R81(CA)
201+80	RT	R2-1	Speed Limit	24 x 30		1	1				
			SNOW REMOVAL AREA	36 x 24			1				35 MPH
201+90	LT	R2-1	Speed Limit	24 x 30		1	1				SPECIAL SIGN LAYOUT (WOOD POST - 1 POST)
205+00	LT		BIKE LANE	24 x 18			1				35 MPH
		R8-3	NO PARKING	24 x 24			1				CALTRANS SIGN SPEC R81(CA)
205+10	RT		SNOW REMOVAL AREA	54 x 30		1					
225+00	RT		BIKE LANE	24 x 18			1				
		R8-3	NO PARKING	24 x 24			1				CALTRANS SIGN SPEC R81(CA)
229+30	LT	R2-1	Speed Limit	24 x 30		1	1				
			SNOW REMOVAL AREA	36 x 24			1				35 MPH
230+35	LT		NEVADA COUNTY LINE	48 x 24		1	1				SPECIAL SIGN LAYOUT
230+40	RT		PLACER COUNTY LINE	48 x 24		1	1				CALTRANS SIGN SPEC G10 (WOOD POST - 1 POST)
			HISTORIC ROUTE US 40	24 x 36			1				CALTRANS SIGN SPEC G10 (WOOD POST - 1 POST)
231+80	RT	R2-1	Speed Limit	24 x 30		1	1				CALTRANS SIGN SPEC S18
235+00	LT		BIKE LANE	24 x 18			1				25 MPH
		R8-3	NO PARKING	24 x 24			1				CALTRANS SIGN SPEC R81(CA)
255+00	RT		BIKE LANE	24 x 18			1				
		R8-3	NO PARKING	24 x 24			1				CALTRANS SIGN SPEC R81(CA)
261+60	RT		DONNER PASS RD EAST	54 x 48		1	1				
265+00	LT		BIKE LANE	24 x 18			1				SPECIAL SIGN LAYOUT (WOOD POST - 2 POSTS)
		R8-3	NO PARKING	24 x 24			1				CALTRANS SIGN SPEC R81(CA)
278+40	LT	R2-1	Speed Limit	24 x 30		1	1				
280+05	RT		NEVADA COUNTY LINE	48 x 24		1	1				25 MPH 35 MPH
280+10	LT		PLACER COUNTY LINE	48 x 24		1	1				CALTRANS SIGN SPEC G10 (WOOD POST - 1 POST)
281+30	RT	R2-1	Speed Limit	24 x 30		1	1				CALTRANS SIGN SPEC G10 (WOOD POST - 1 POST)
			SNOW REMOVAL AREA	36 x 24			1				35 MPH
288+00	RT		WELCOME TO DONNER SKI RANCH								SPECIAL SIGN LAYOUT (WOOD POST - 1 POST)
289+00	LT		BIKE LANE	24 x 18			1		1		
		R8-3	NO PARKING	24 x 24			1				CALTRANS SIGN SPEC R81(CA)
293+50	RT	R1-1	Stop	30 x 30		1	1				
295+00	RT		BIKE LANE	24 x 18			1				
		R8-3	NO PARKING	24 x 24			1				CALTRANS SIGN SPEC R81(CA)
302+00	RT		BIKE LANE	24 x 18			1				
			END	8 x 5			1				CALTRANS SIGN SPEC R81(CA)
302+60	LT	R2-1	Speed Limit	24 x 30		1	1				CALTRANS SIGN SPEC R81B(CA)
			SNOW REMOVAL AREA	36 x 24			1				35 MPH
302+70	RT		HISTORIC DONNER SUMMIT	54 x 36		1	1				SPECIAL SIGN LAYOUT (WOOD POST - 1 POST)
303+20	RT		PACIFIC CREST TRAIL	16 x 24		1	1				CALTRANS SIGN SPEC G16 MODIFIED (WOOD POST - 2 POSTS)
304+00	LT		HISTORIC DONNER SUMMIT	54 x 36		1	1				
305+40	RT	W1-5L	Winding Road Left	30 x 30		1	1				CALTRANS SIGN SPEC G16 MODIFIED (WOOD POST - 2 POSTS)
		W13-1P	Advisory Speed (plaque)	16 x 16			1				
306+90	RT	R4-11	BIKES MAY USE FULL LANE	30 x 30			1				25 MPH

Notes:
1. Use galvanized metal square tubular steel posts in accordance with 77-1.1.1.1.

- Notes:
1. Use galvanized metal square tubular steel posts in accordance with FP-14 718.04(B)(2) and The Nevada County Standard Sign and Post Installation Detail for all signs unless otherwise noted as wood post in remarks above.
 2. Delineator, Type Snow Pole to be 1" OD schedule 40 pipe or approved equivalent.



U.S. DEPARTMENT OF TRANSPORTATION
FEDERAL HIGHWAY ADMINISTRATION
CENTRAL FEDERAL LANDS HIGHWAY DIVISION

PERMANENT SIGN SUMMARY
Sheet 2 of 3

3:19:07 PM Q:\2015 Projects\15-030.02 Donner Pass Preliminary Design - CFLHD\CA FLAP NEV 40(1)\Roadway\CADD_Sheets\B-Summary\TAB(DOWN)\CA40_Signing Summary.dgn User: mcarlson_


STATE	PROJECT	SHEET NUMBER
CA	CA FLAP NEV 40(1) DONNER PASS	816

PERMANENT SIGN SUMMARY											
Station	Side	MUTCD Reference	Description	Item Number	20301-0700	20301-2300	63301-0000	63309-1000	63316-1000	63318-1000	Remarks
				Sign Panel	REMOVAL OF DELINEATOR	REMOVAL OF SIGN/MARKER	SIGN SYSTEM	DELINEATOR, TYPE SNOW POLE	REMOVE AND RESET SIGN	SNOW POLE HOLDER	
				In x In	EACH	EACH	EACH	EACH	EACH	EACH	
308+00	RT		WATCH FOR STOPPED VEHICLES	36 x 36			1				
		W7-3AP	Next XX Miles (plaque)	24 x 18							CALTRANS SIGN SPEC SW60(CA)
309+80	RT	W8-5	Slippery When Wet	30 x 30		1	1				NEXT 3 MILES
			ICY	30 x 30							
316+60	RT		SLIDE AREA	30 x 30		1	1				CALTRANS SIGN SPEC W43
322+90	RT	W5-2	Narrow Bridge	36 x 36		1	1				CALTRANS SIGN SPEC W38
325+00	LT		BIKE LANE	24 x 18			1				
		R8-3	NO PARKING	24 x 24							CALTRANS SIGN SPEC R81(CA)
326+70	RT		OM-3R OBJECT MARKER	12 x 36			1				
326+90	LT		OM-3L OBJECT MARKER	12 x 36			1				CALTRANS TYPE P MARKER
329+30	LT		OM-3R OBJECT MARKER	12 x 36			1				CALTRANS TYPE P MARKER
329+40	RT		OM-3L OBJECT MARKER	12 x 36			1				CALTRANS TYPE P MARKER
332+50	LT	R4-11	BIKES MAY USE FULL LANE	30 x 30			1				CALTRANS TYPE P MARKER
333+40	LT	W5-2	Narrow Bridge	36 x 36		1	1				
			VISTA POINT	36 x 18							
335+00	RT		WATCH FOR STOPPED VEHICLES	36 x 36			1				CALTRANS SIGN SPEC G8-4
		W7-3AP	Next XX Miles (plaque)	24 x 18							CALTRANS SIGN SPEC SW60(CA)
335+00	RT	R4-11	BIKES MAY USE FULL LANE	30 x 30			1				NEXT 2 MILES
350+00	LT		BIKE LANE	24 x 18			1				
		R8-3	NO PARKING	24 x 24							CALTRANS SIGN SPEC R81(CA)
362+50	RT	R4-11	BIKES MAY USE FULL LANE	30 x 30			1				
380+00	LT		BIKE LANE	24 x 18			1				
		R8-3	NO PARKING	24 x 24							CALTRANS SIGN SPEC R81(CA)
381+50	RT		SLIDE AREA	30 x 30		1	1				
396+50	RT	R4-11	BIKES MAY USE FULL LANE	30 x 30			1				CALTRANS SIGN SPEC W38
400+80	LT		SLIDE AREA	30 x 30		1	1				
410+00	LT		BIKE LANE	24 x 18			1				CALTRANS SIGN SPEC W38
		R8-3	NO PARKING	24 x 24							CALTRANS SIGN SPEC R81(CA)
415+00	LT		WATCH FOR STOPPED VEHICLES	36 x 36			1				
		W7-3AP	Next XX Miles (plaque)	24 x 18							CALTRANS SIGN SPEC SW60(CA)
419+50	LT		SLIDE AREA	30 x 30		1	1				NEXT 3 MILES
420+30	LT	W1-5L	Winding Road Left	30 x 30		1	1				CALTRANS SIGN SPEC W38
		W13-P	Advisory Speed (plaque)	18 x 18							
		W7-3AP	Next XX Miles (plaque)	24 x 18							25 MPH
424+20	RT	R4-11	BIKES MAY USE FULL LANE	30 x 30			1				NEXT 3 MILES
429+20	LT		ICY	30 x 30		1	1				
		W8-5	Slippery When Wet	30 x 30							CALTRANS SIGN SPEC W43
431+20	LT		WATCH FOR SNOW REMOVAL EQUIP	36 x 36		1	1				
435+00	LT		LITTER REMOVAL								CALTRANS SIGN SPEC SW58
437+00	RT	R2-1	Speed Limit	24 x 30		1	1		1		
			SPEED ENFORCED BY RADAR	24 x 30							25 MPH 35 MPH
442+30	LT		BIKE LANE	24 x 18							CALTRANS SIGN SPEC R48
		R8-3	NO PARKING	24 x 24			1				CALTRANS SIGN SPEC R81(CA)
Rainbow Bridge Parking		R7-8	RESERVED PARKING	12 x 18		1	1				
		R7-8P	Van Accessible (plaque)	18 x 9							REMOVE EXISTING SIGN SYSTEM
		R7-8	RESERVED PARKING	12 x 18			1				
		R7-8P	Van Accessible (plaque)	18 x 9							
		R8-3	NO PARKING	24 x 24			1				
		R8-3	NO PARKING	24 x 24			1				
			Delineators		416			355		115	
TOTALS						416	63	99	355	2	115

Notes:

1. Use galvanized metal square tubular steel posts in accordance with FP-14 718.04(B)(2) and The Nevada County Standard Sign and Post Installation Detail for all signs unless otherwise noted as wood post in remarks above.

2. Delineator, Type Snow Pole to be 1" OD schedule 40 pipe or approved equivalent.

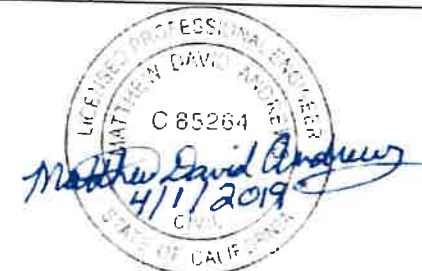

U.S. DEPARTMENT OF TRANSPORTATION
FEDERAL HIGHWAY ADMINISTRATION
CENTRAL FEDERAL LANDS HIGHWAY DIVISION

PERMANENT SIGN SUMMARY

Sheet 3 of 3

10:59:21 AM Q:\2015 Projects\15-030.02 Donner Pass Preliminary Design - CFHD\CA FLAP NEV 40(1)\Roadway\CADD_Sheets\B-Summ\TAB\DONN\CA40_Striping Summary.dgn User: dhelling 8/13/2019

STATE	PROJECT	SHEET NUMBER
CA	CA FLAP NEV 40(1) DONNER PASS	817

PERMANENT PAVEMENT MARKING SUMMARY																	
Station to Station	LEFT		RIGHT			Item Number					63402-2300	63403-0400	63405-1350	63405-1650	63407-0200	Remarks	
	Bike Lane Solid White 6 inches	Centerline Solid Yellow 4 inches	Edge Solid White 4 inches	Bike Lane Solid White 6 inches	Centerline Solid Yellow 4 inches	Parking Stripe Blue Solid 4 inches	Parking Stripe Solid White 4 inches	Shared Lane White 9 SQFT	"Bike Lane" White 12 SQFT	Bike Lane Arrow White	PAVEMENT MARKINGS, TYPE L, SOLID	PAVEMENT MARKINGS, TYPE D	PAVEMENT MARKINGS, TYPE D, STRAIGHT ARROW	PAVEMENT MARKINGS, TYPE D, ACCESSIBILITY SYMBOL	RECESSED PAVEMENT MARKER, BI-DIRECTIONAL REFLECTIVE		
	LNFT	LNFT	LNFT	LNFT	LNFT		LNFT	EACH	EACH	EACH	MILE	SQFT	EACH	EACH	EACH		
104+50 - 305+00	20,050	20,050		20,050	20,050				26	26	15.2	312	26				
305+00 - 442+50	13,750	13,750	13,750		13,750			10	9	9	10.4	180	9			Bike markings every 1/4 mile	
Rainbow Bridge Parking Area						400	600									Bike markings every 1/4 mile	
Recessed Centerline Markiners											0.2			2		"Type D markers	
															1410	TYPE C-YELLOW RECESSED MARKER (@ 24' SPACING)	
TOTALS											25.8	492	35	2	2,820	2,410	

* Type D markings were placed with Type L(MMA Paint)material



U.S. DEPARTMENT OF TRANSPORTATION
FEDERAL HIGHWAY ADMINISTRATION
CENTRAL FEDERAL LANDS HIGHWAY DIVISION

PERMANENT PAVEMENT
MARKING SUMMARY

STATE	PROJECT	SHEET NUMBER
CA	CA FLAP NEV 40(1) DONNER PASS	C1



0 100' 200'
Scale in Feet

POB 100+00.00 100+00

Existing 30" CMP

PC 102+96.63

I-80 EB on-ramp

105+00

PT 105+67.99

113°55'06"

I-80 EB off-ramp

Stream
Curve = CL-1
PI 104+36.21
 $\Delta = 33^\circ 04' 52''$ (LT)
R = 470.00'
T = 139.58'
L = 271.37'


Existing 30" CMP

Donner Pass Road

Begin Project
Station 104+50.00
CA FLAP NEV 40(1)
N 2248358.40
E 7016754.20

Superelevation Diagram

Match existing superelevation

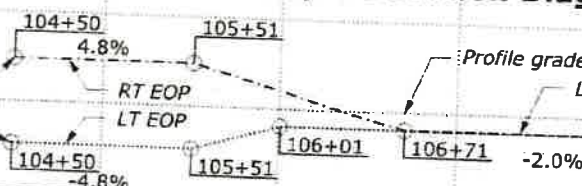

Existing ground

VPI=104+50.00
Match existing

SSD = 569'
K = 87
200' VC

VPI=105+65.09
EL. = 6690.79'

Profile grade

2.952% 0.650%



10.0%
0%
-10.0%
6720
6710
6700
6690
6680
6670
6660

10.0%
0%
-10.0%
6720
6710
6700
6690
6680
6670
6660


100+00 101+00 102+00 103+00 104+00 105+00 106+00 107+00 108+00

3/21/2019 7:18:48 AM Q:\2015 Projects\15-030.02 Donner Pass Preliminary Design - C:\HD\CA FLAP NEV 40(1)\Roadway\CADD_Sheets\C-M\PNP\PNP\DONN\CA40_2.dgn User: mcarlson

STATE	PROJECT	SHEET NUMBER
CA	CA FLAP NEV 40(1) DONNER PASS	C2

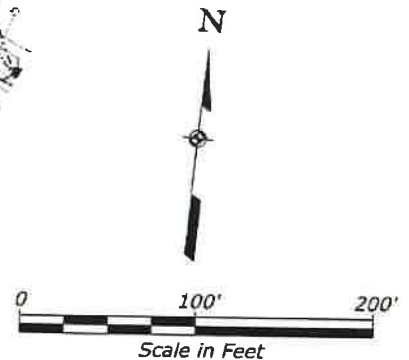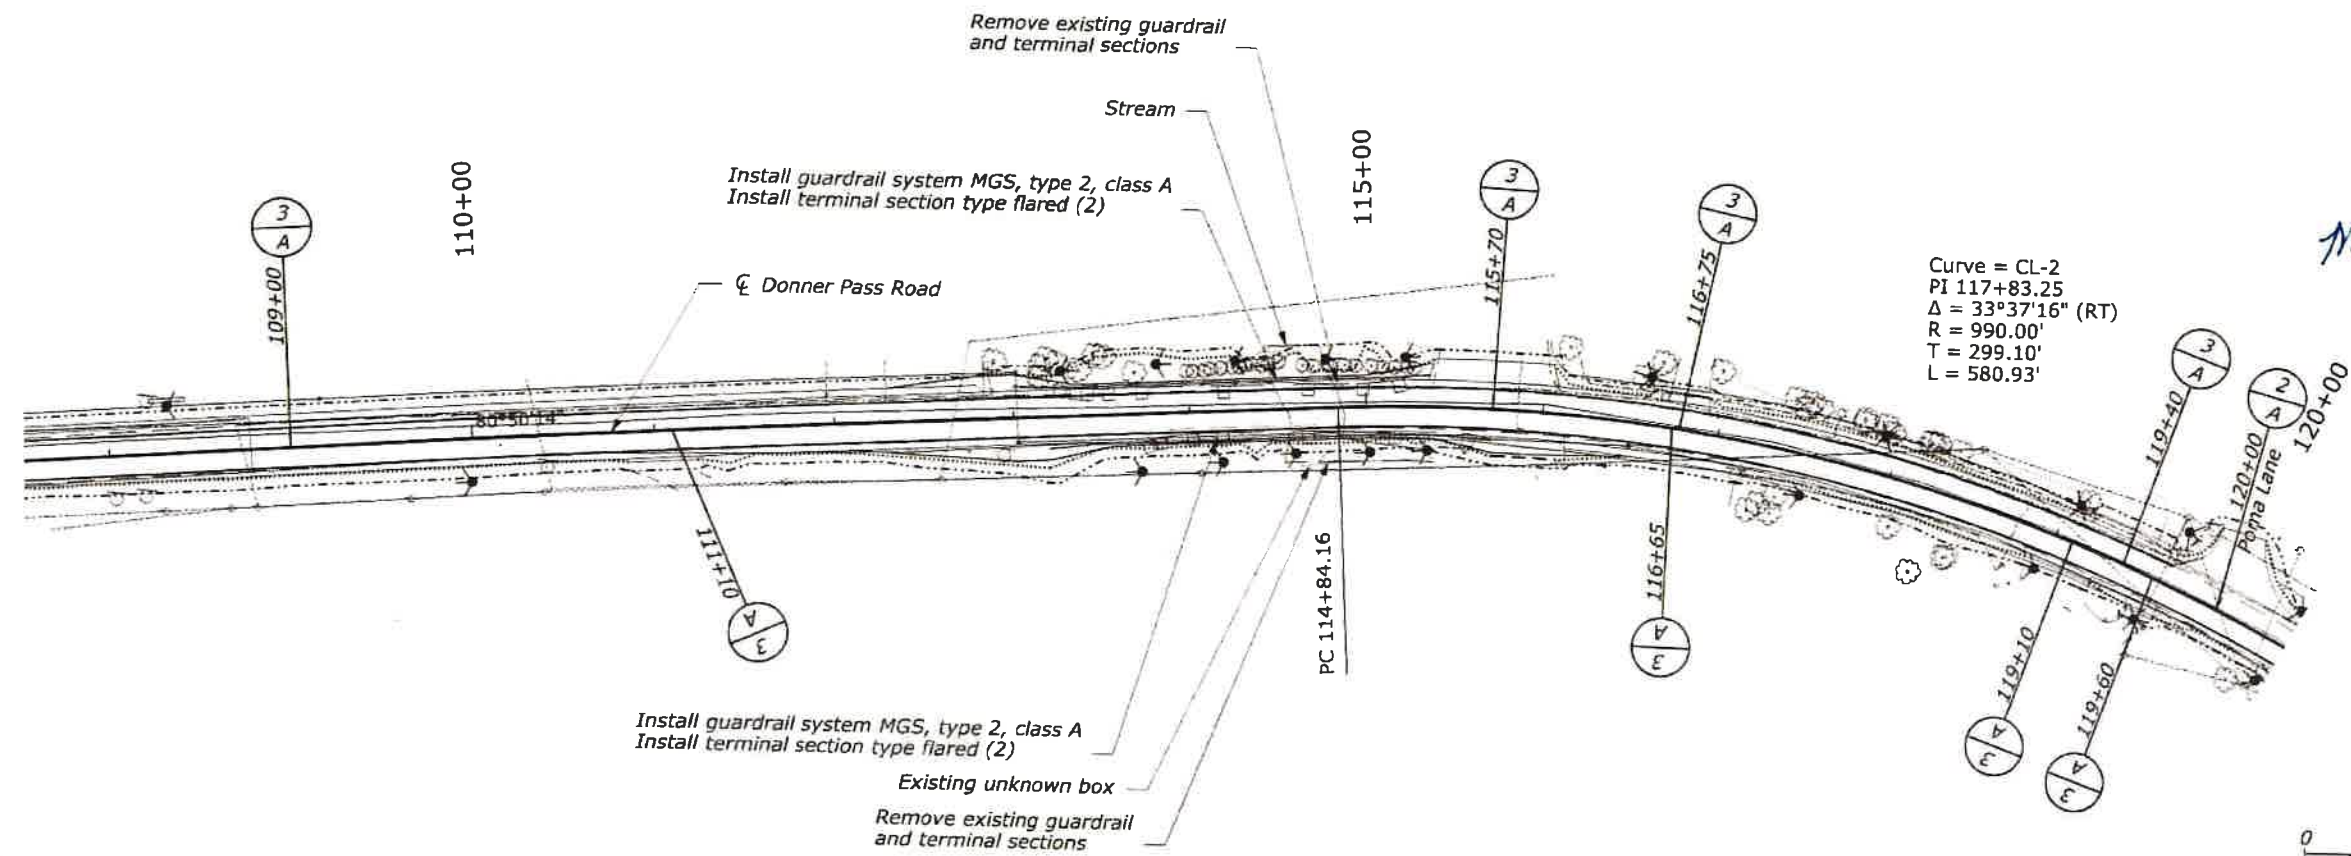


Superelevation Diagram

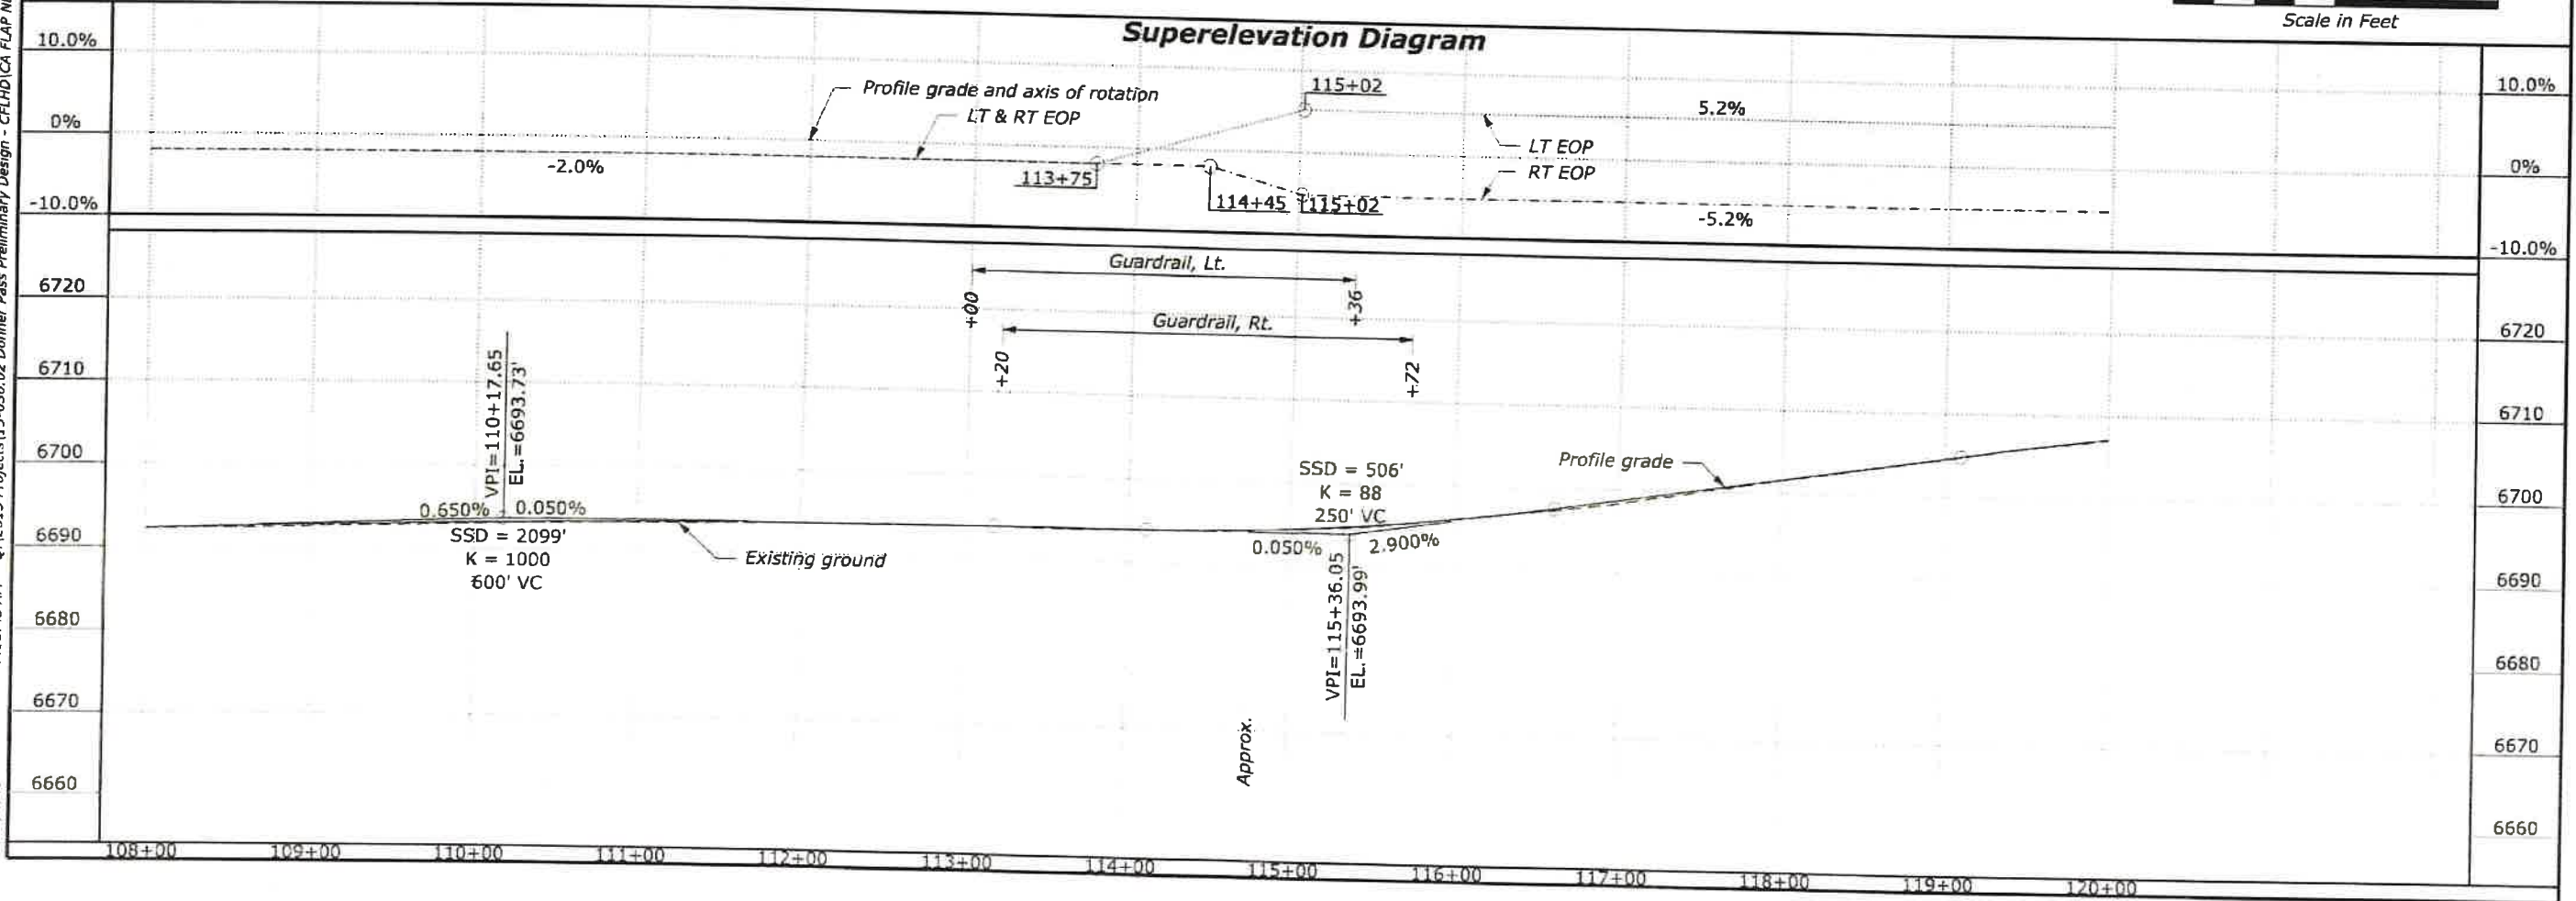


3/21/2019 7:19:49 AM Q:\2015 Projects\15-030.02 Donner Pass Preliminary Design - CFLHD\CA FLAP NEV 40(1)\Roadway\CADD_Sheets\C-ML_P\PI\PI\DOWN\CA40_3.dgn User: mcarlson

STATE	PROJECT	SHEET NUMBER
CA	CA FLAP NEV 40(1) DONNER PASS	C3

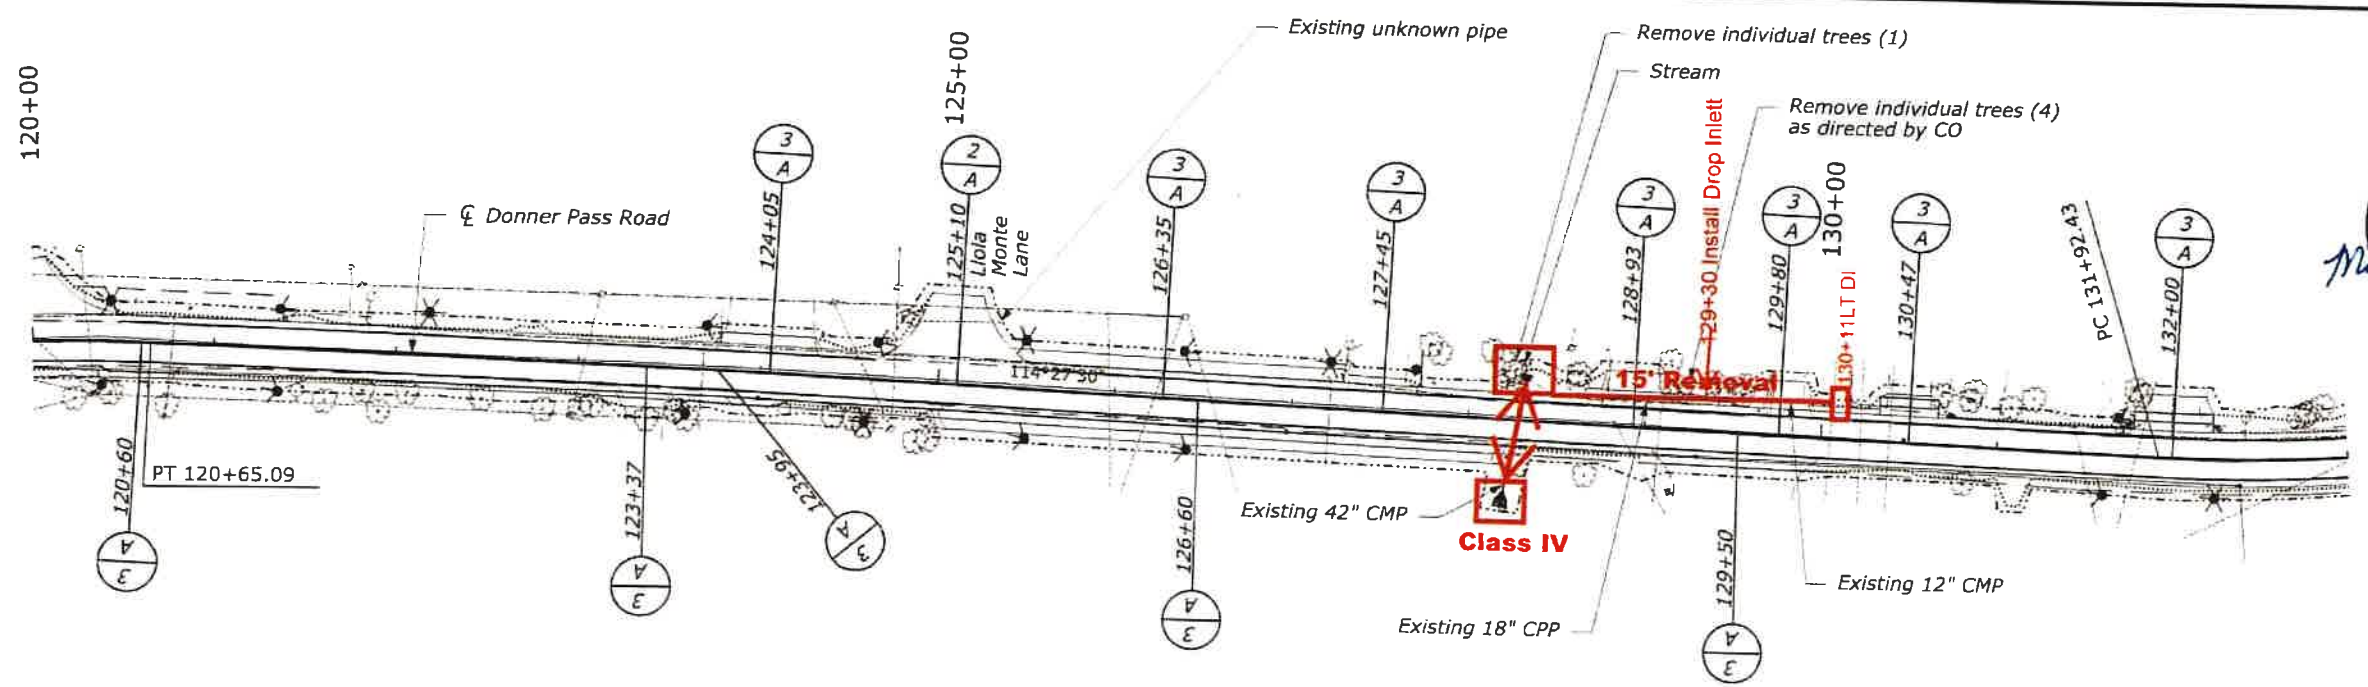

Superelevation Diagram

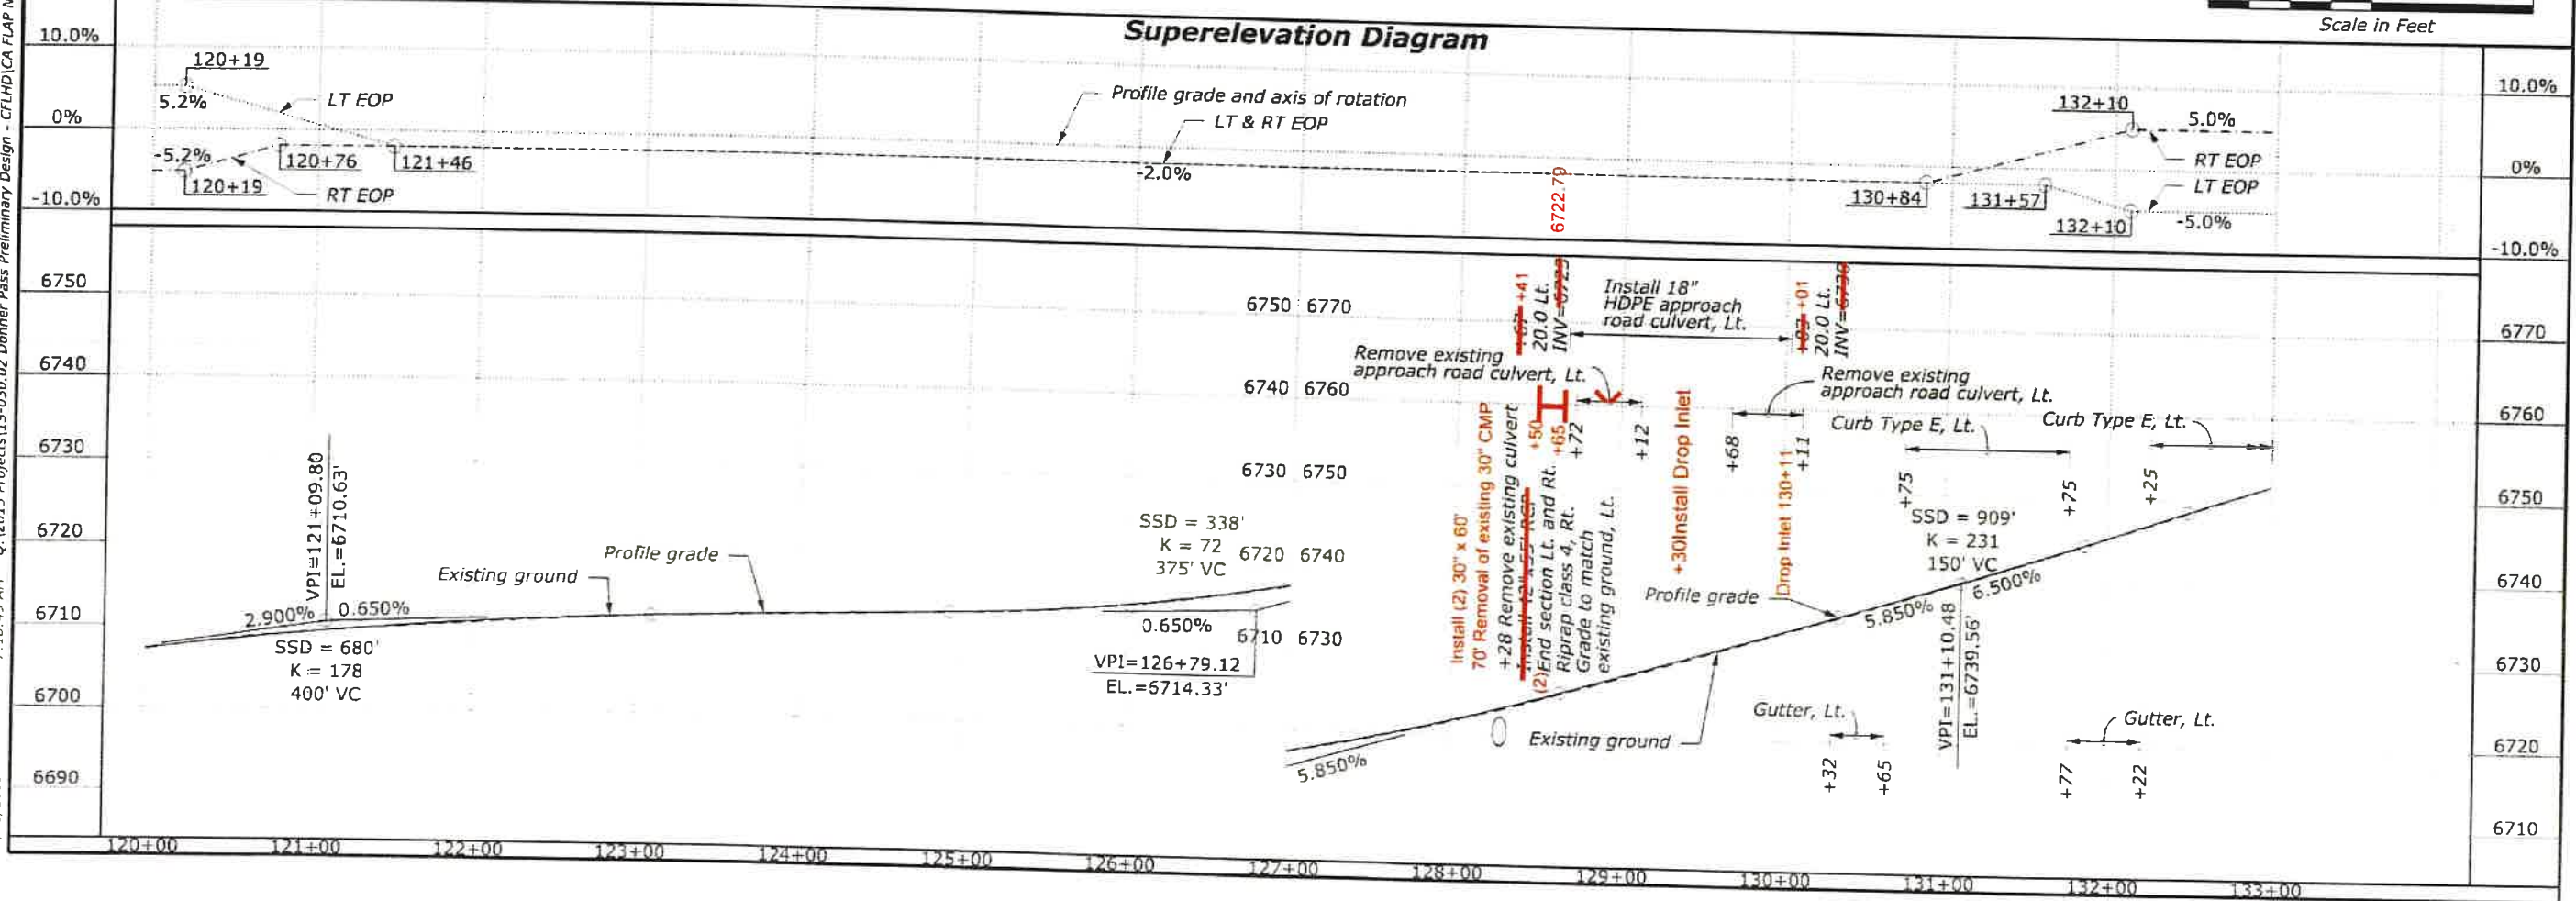


STATE	PROJECT	SHEET NUMBER
CA	CA FLAP NEV 40(1) DONNER PASS	C4


Revised 10/08/19

User: ppechla


10/9/2019 2:58:51 PM Q:\2015 Projects\15-030.02 Donner Pass Preliminary Design - C:\HD\CA FLAP NEV 40(1)\Roadway\CAAD_Sheets\C-M\PM\PM\DONN\CA40_4.dgn

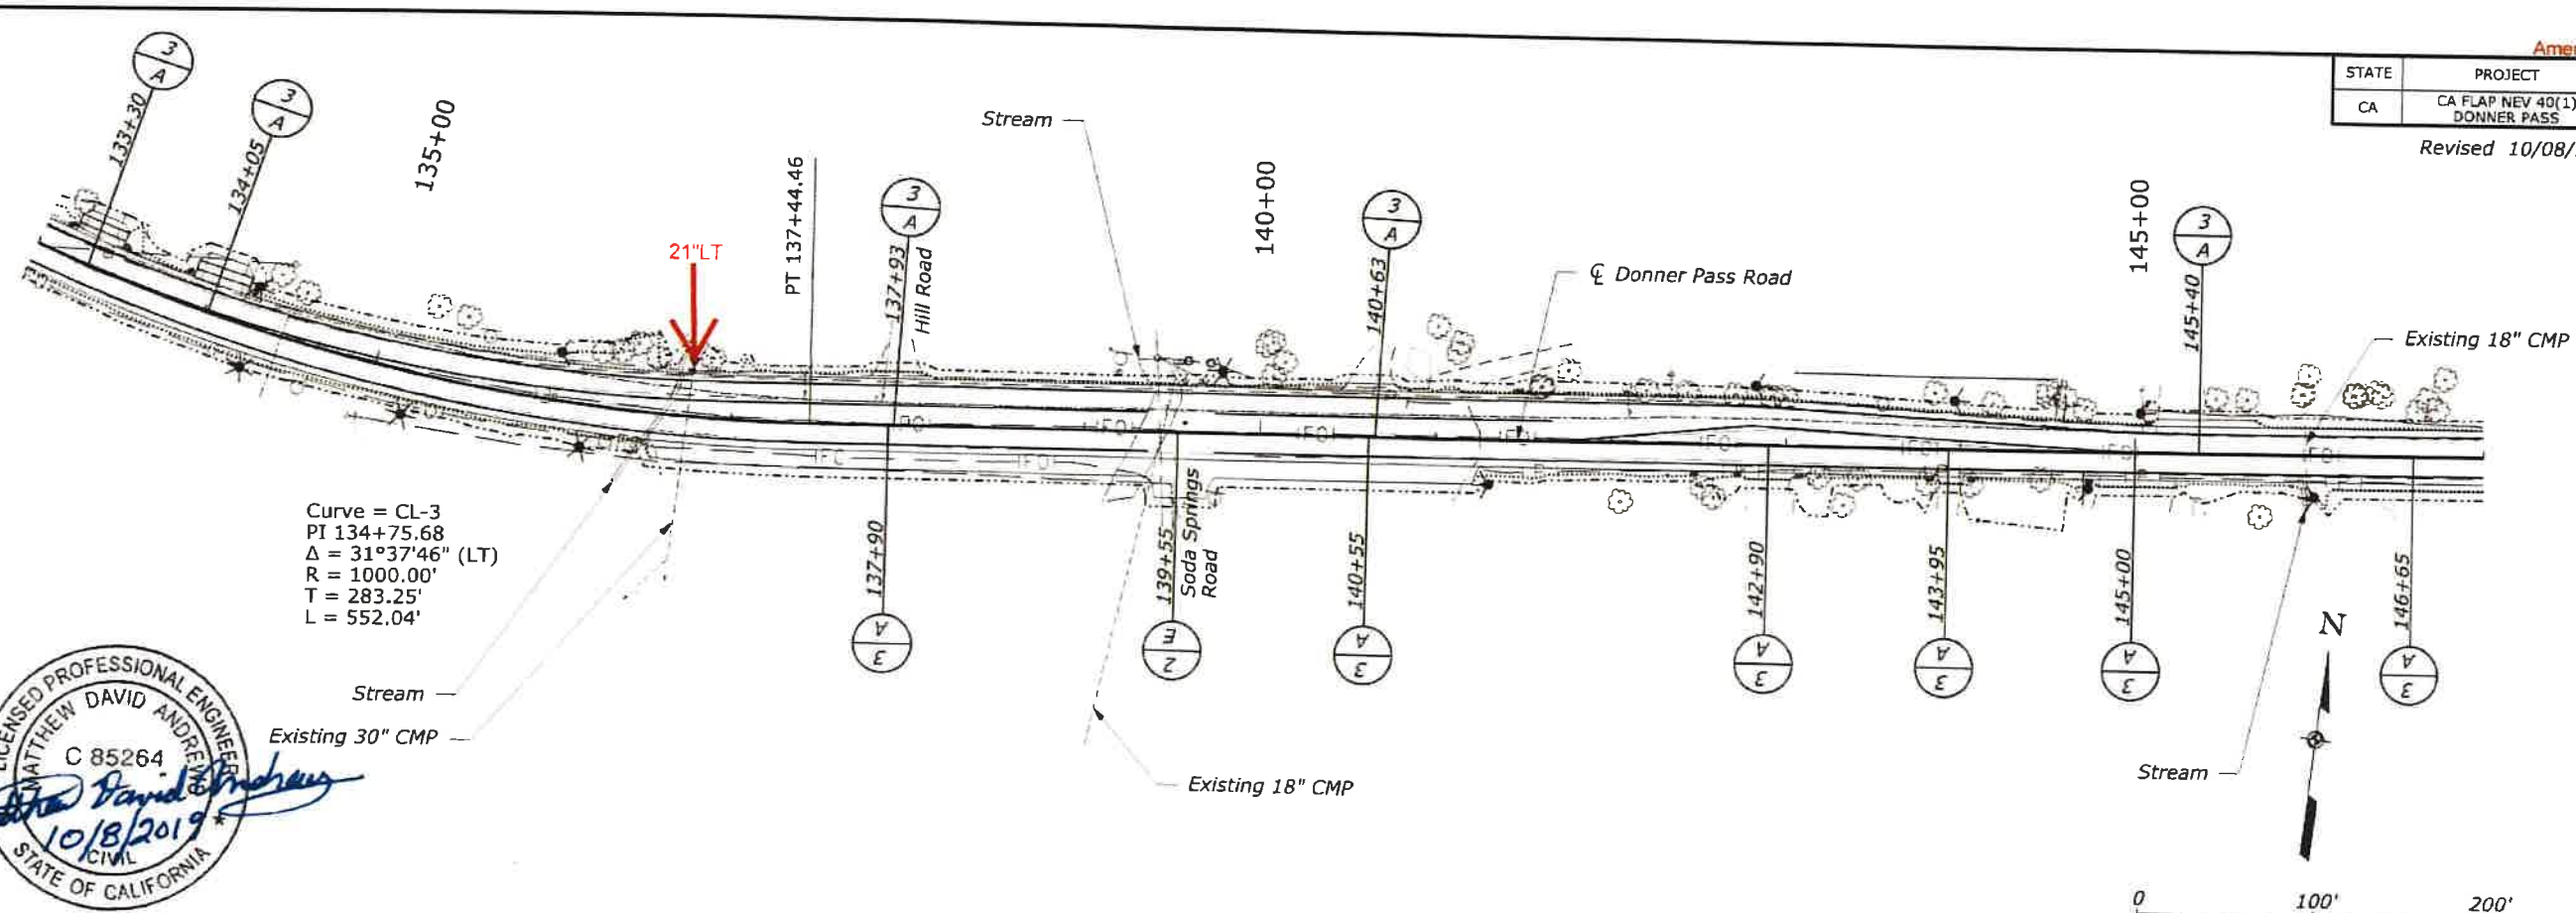

Curve = CL-3
PI 134+75.68
 $\Delta = 31^\circ 37' 46''$ (LT)
R = 1000.00'
T = 283.25'
L = 552.04'

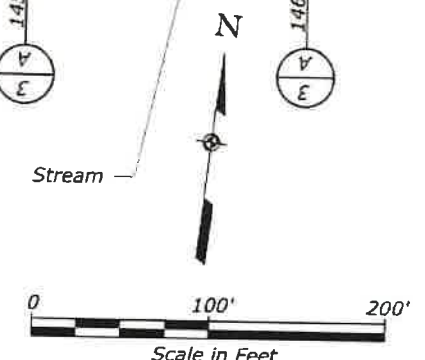



Superelevation Diagram

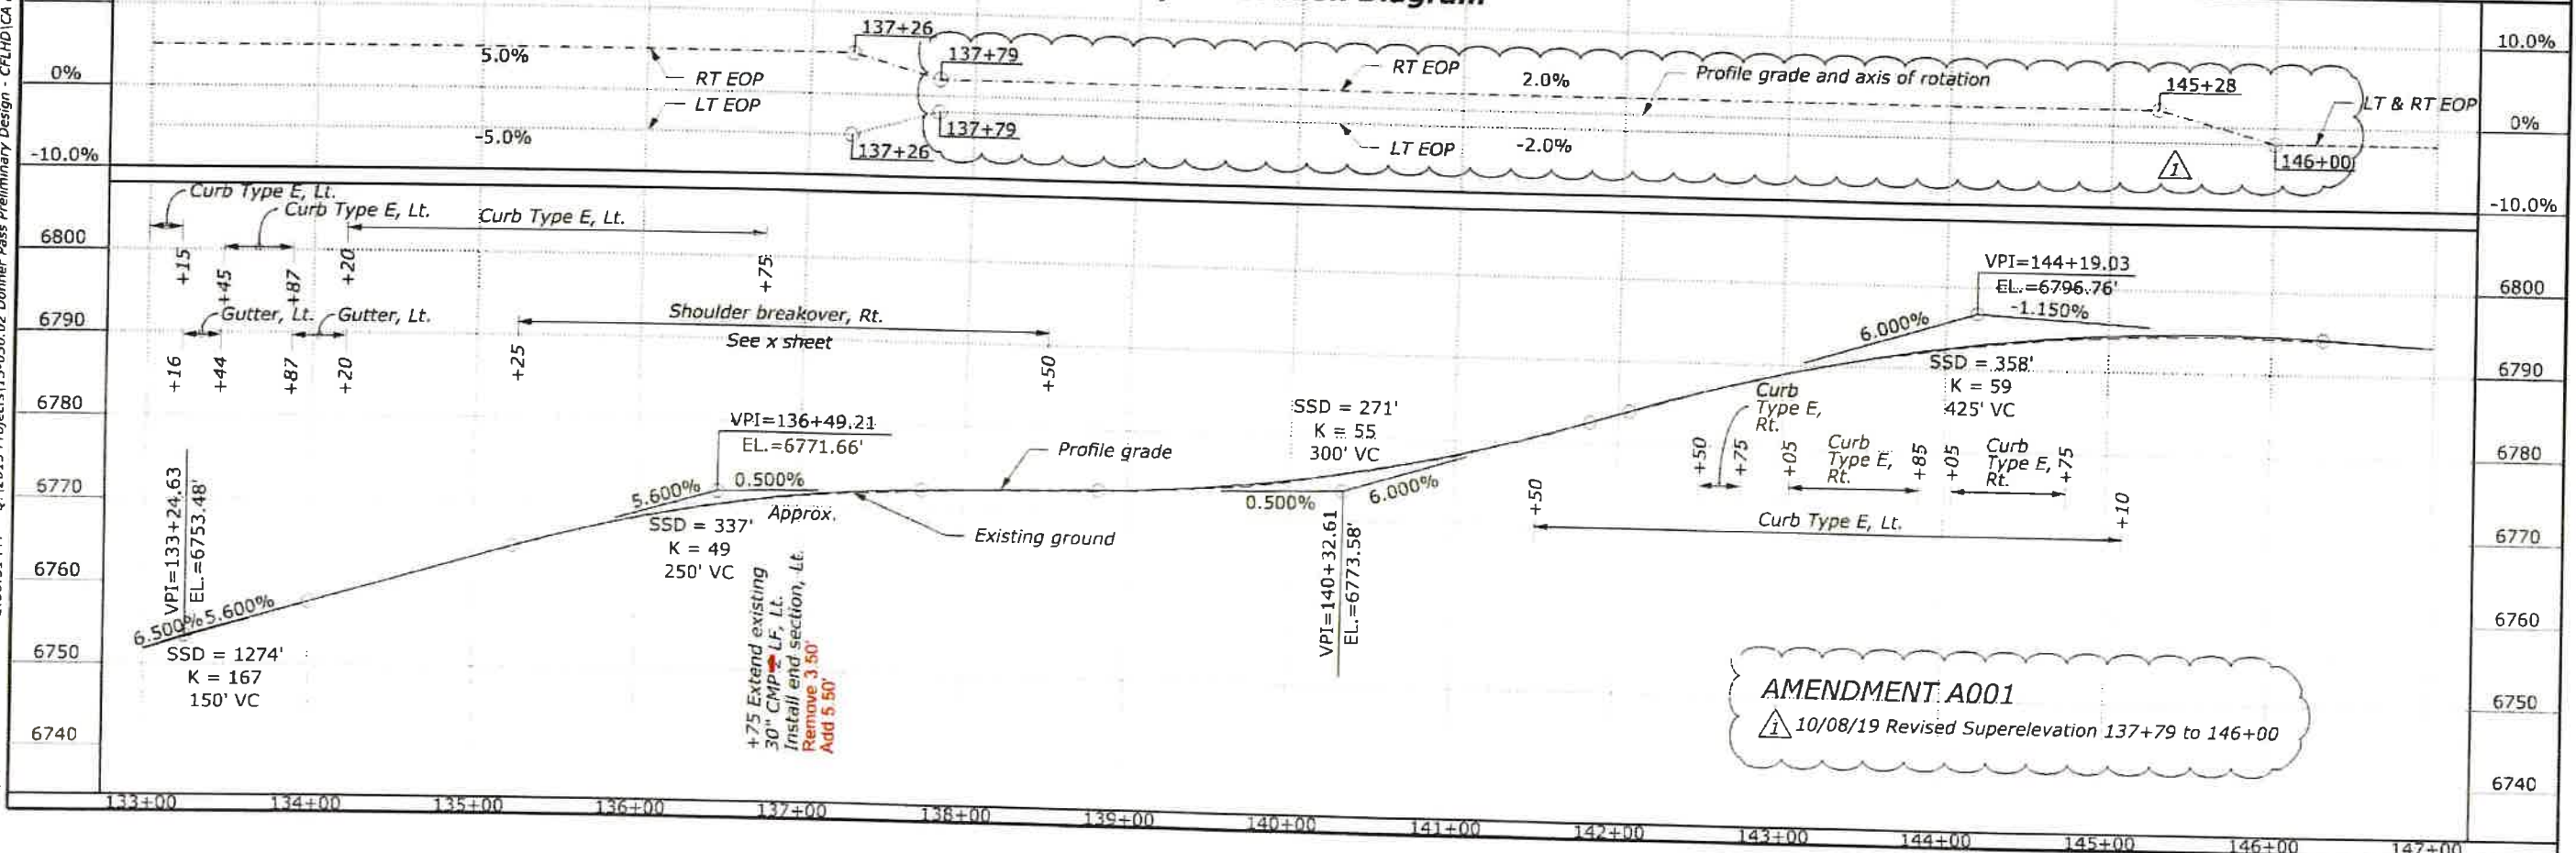


AMENDMENT A001
10/08/19 Revised Superelevation 137+79 to 146+00

3/21/2019 7:18:50 AM Q:\2015 Projects\15-030.02 Donner Pass Preliminary Design - CML\CA FLAP NEV 40(1)\Roadway\CADD_Sheets\C-ML_PWP\PNP(DONN)\CA40_5.dgn User: mcarlson

STATE	PROJECT	SHEET NUMBER
CA	CA FLAP NEV 40(1) DONNER PASS	C5

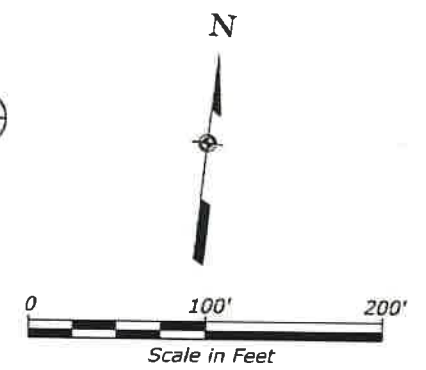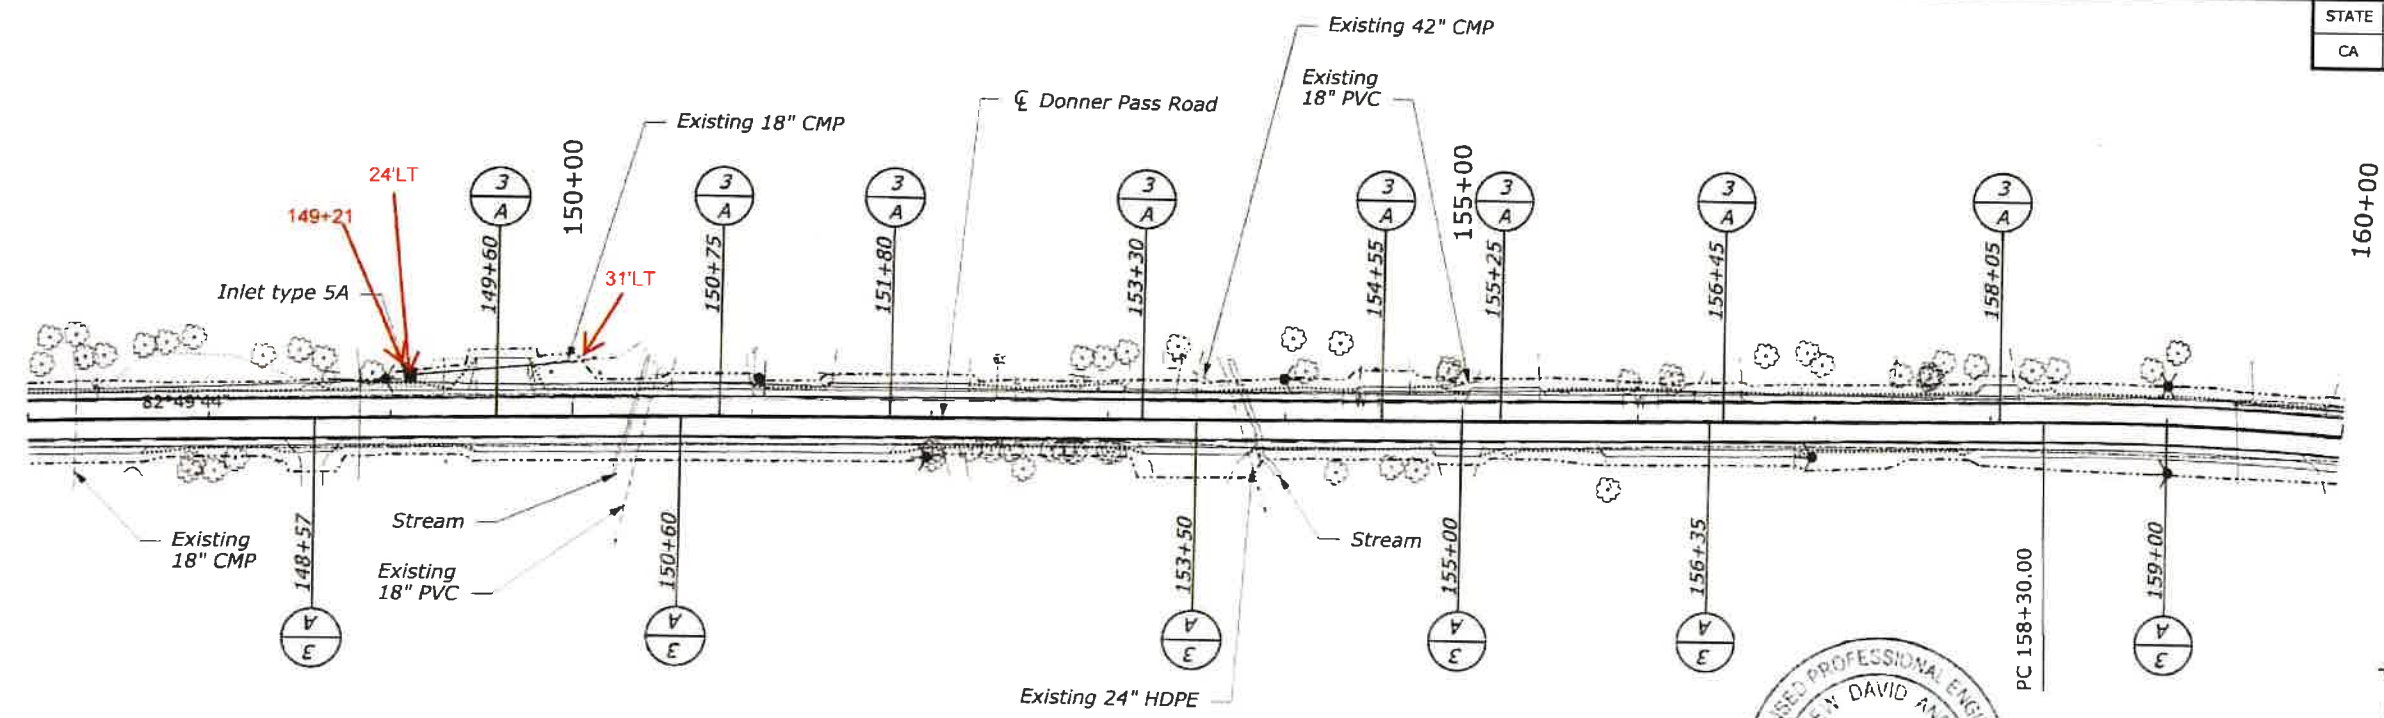



Superelevation Diagram

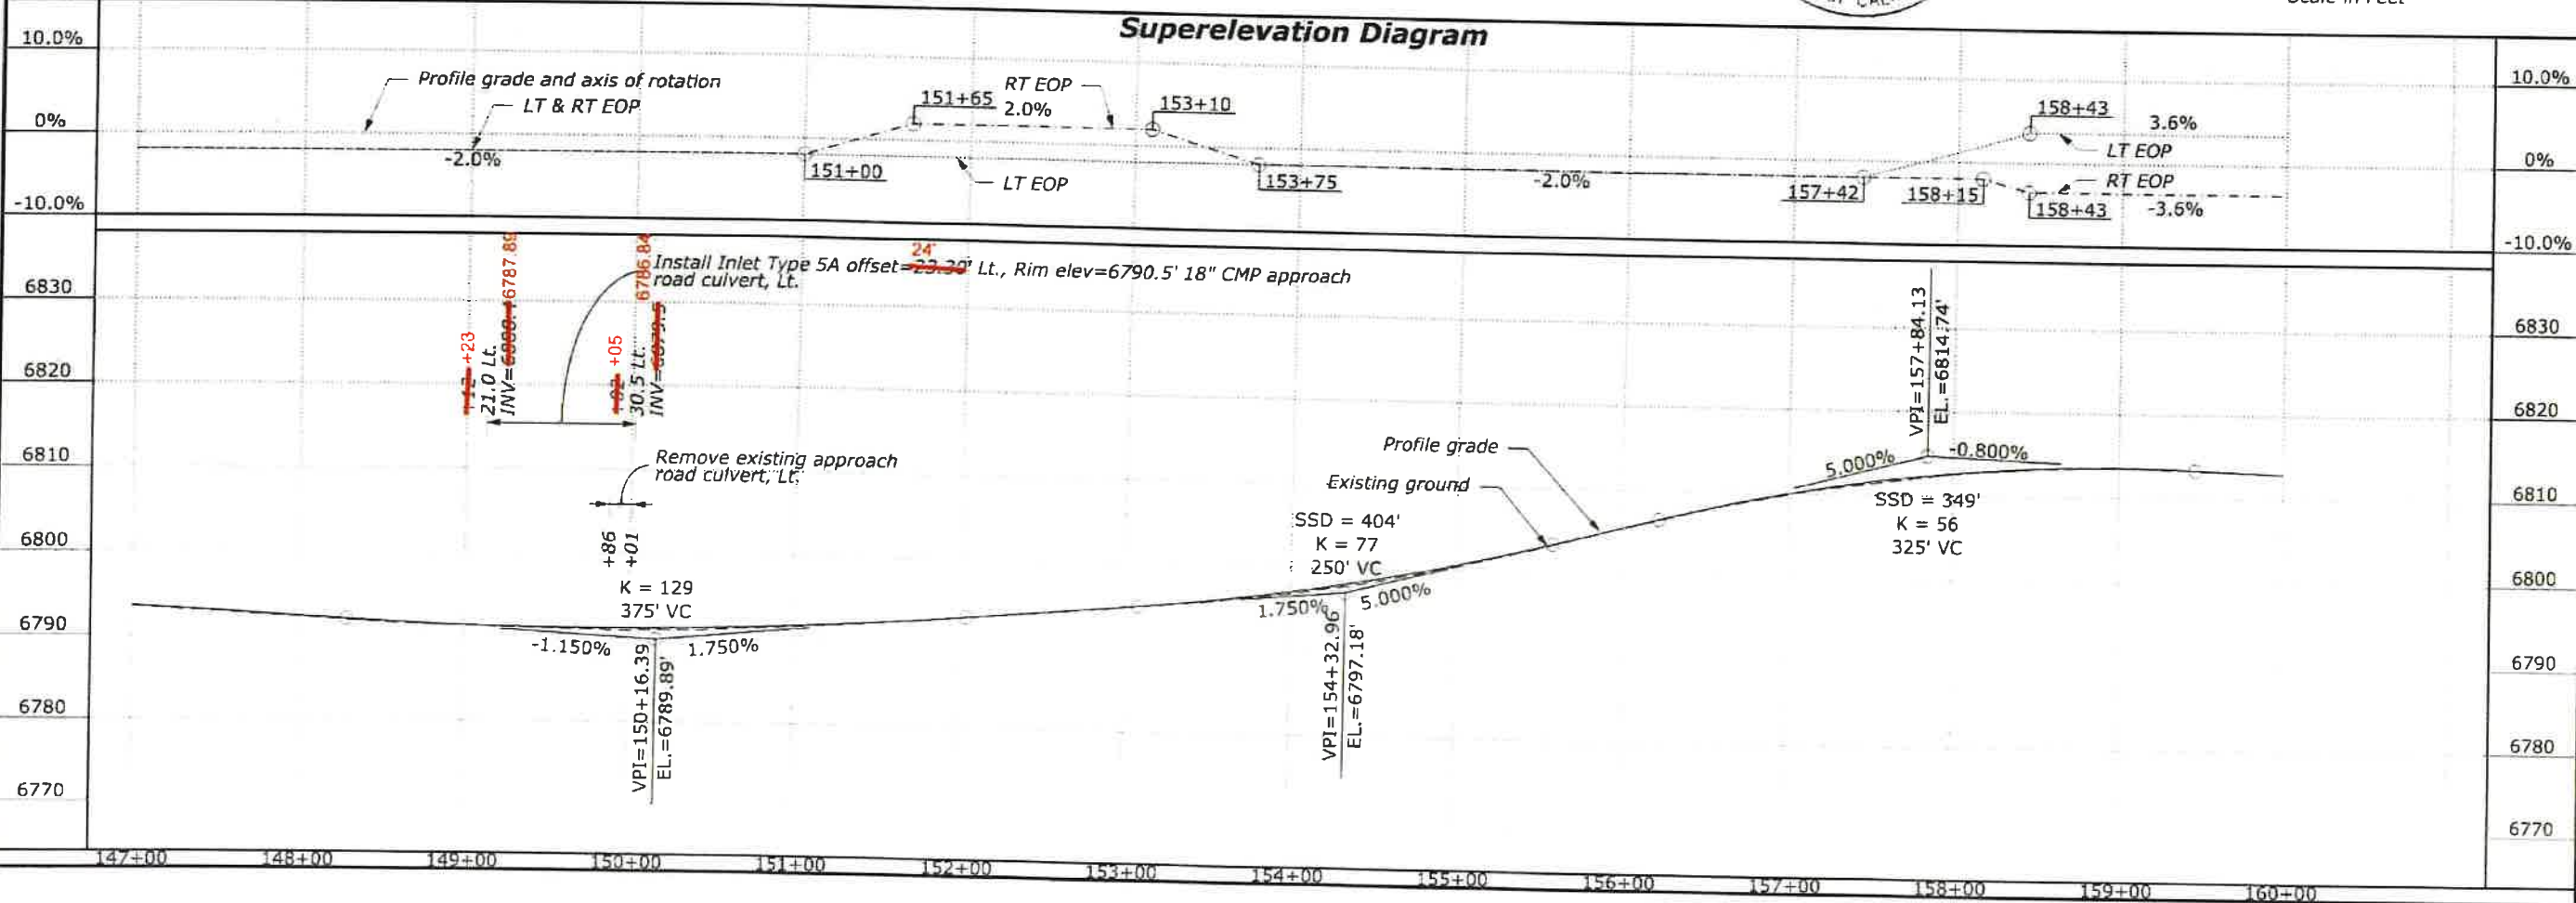

...User: mcarlson...

3/21/2019 7:18:51 AM Q:\2015 Projects\15-030.02 Donner Pass Preliminary Design - C:\HDD\CA FLAP NEV 40(1)\Roadway\CADD_Sheets\CA-ML_PNP\PNP\DONNY\CA40_6.dgn


STATE	PROJECT	SHEET NUMBER
CA	CA FLAP NEV 40(1) DONNER PASS	C6

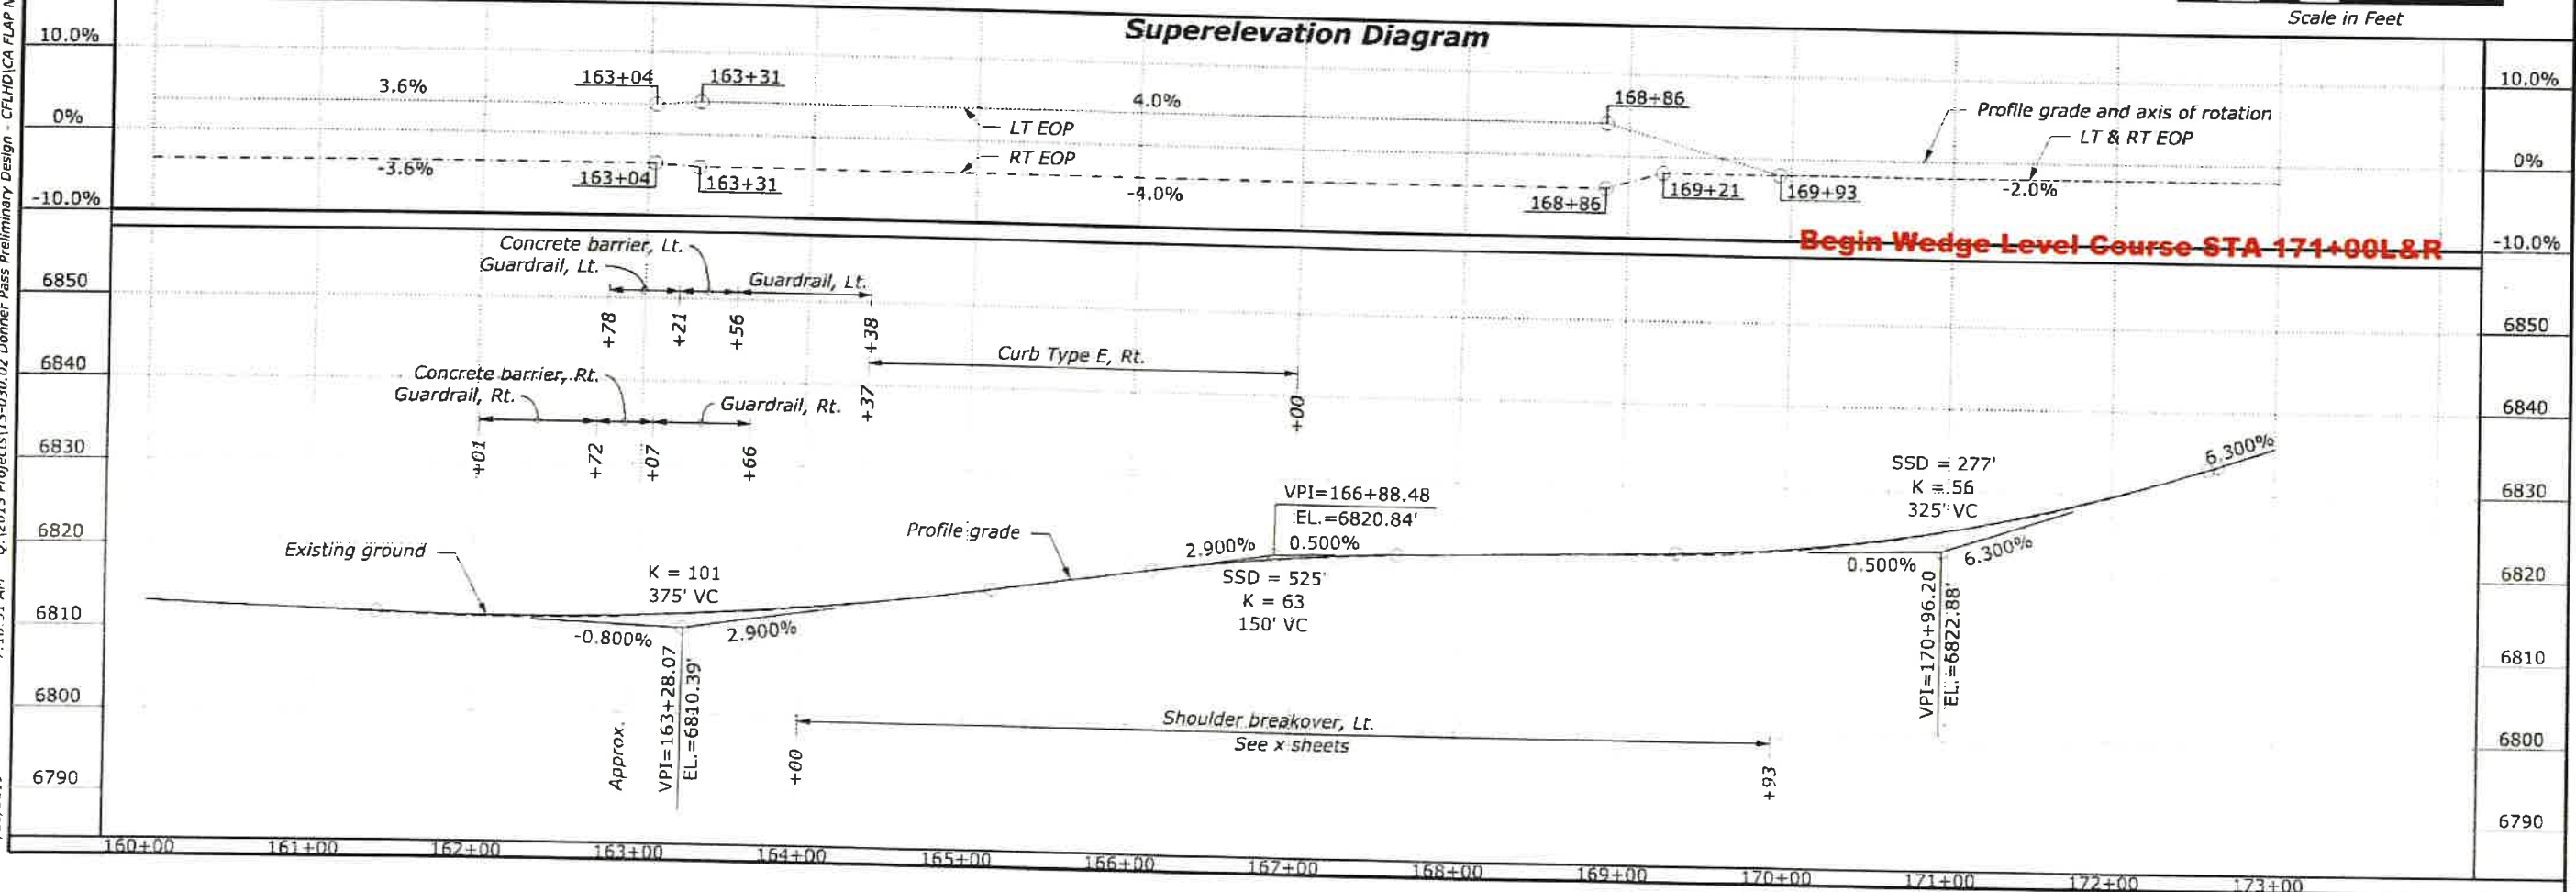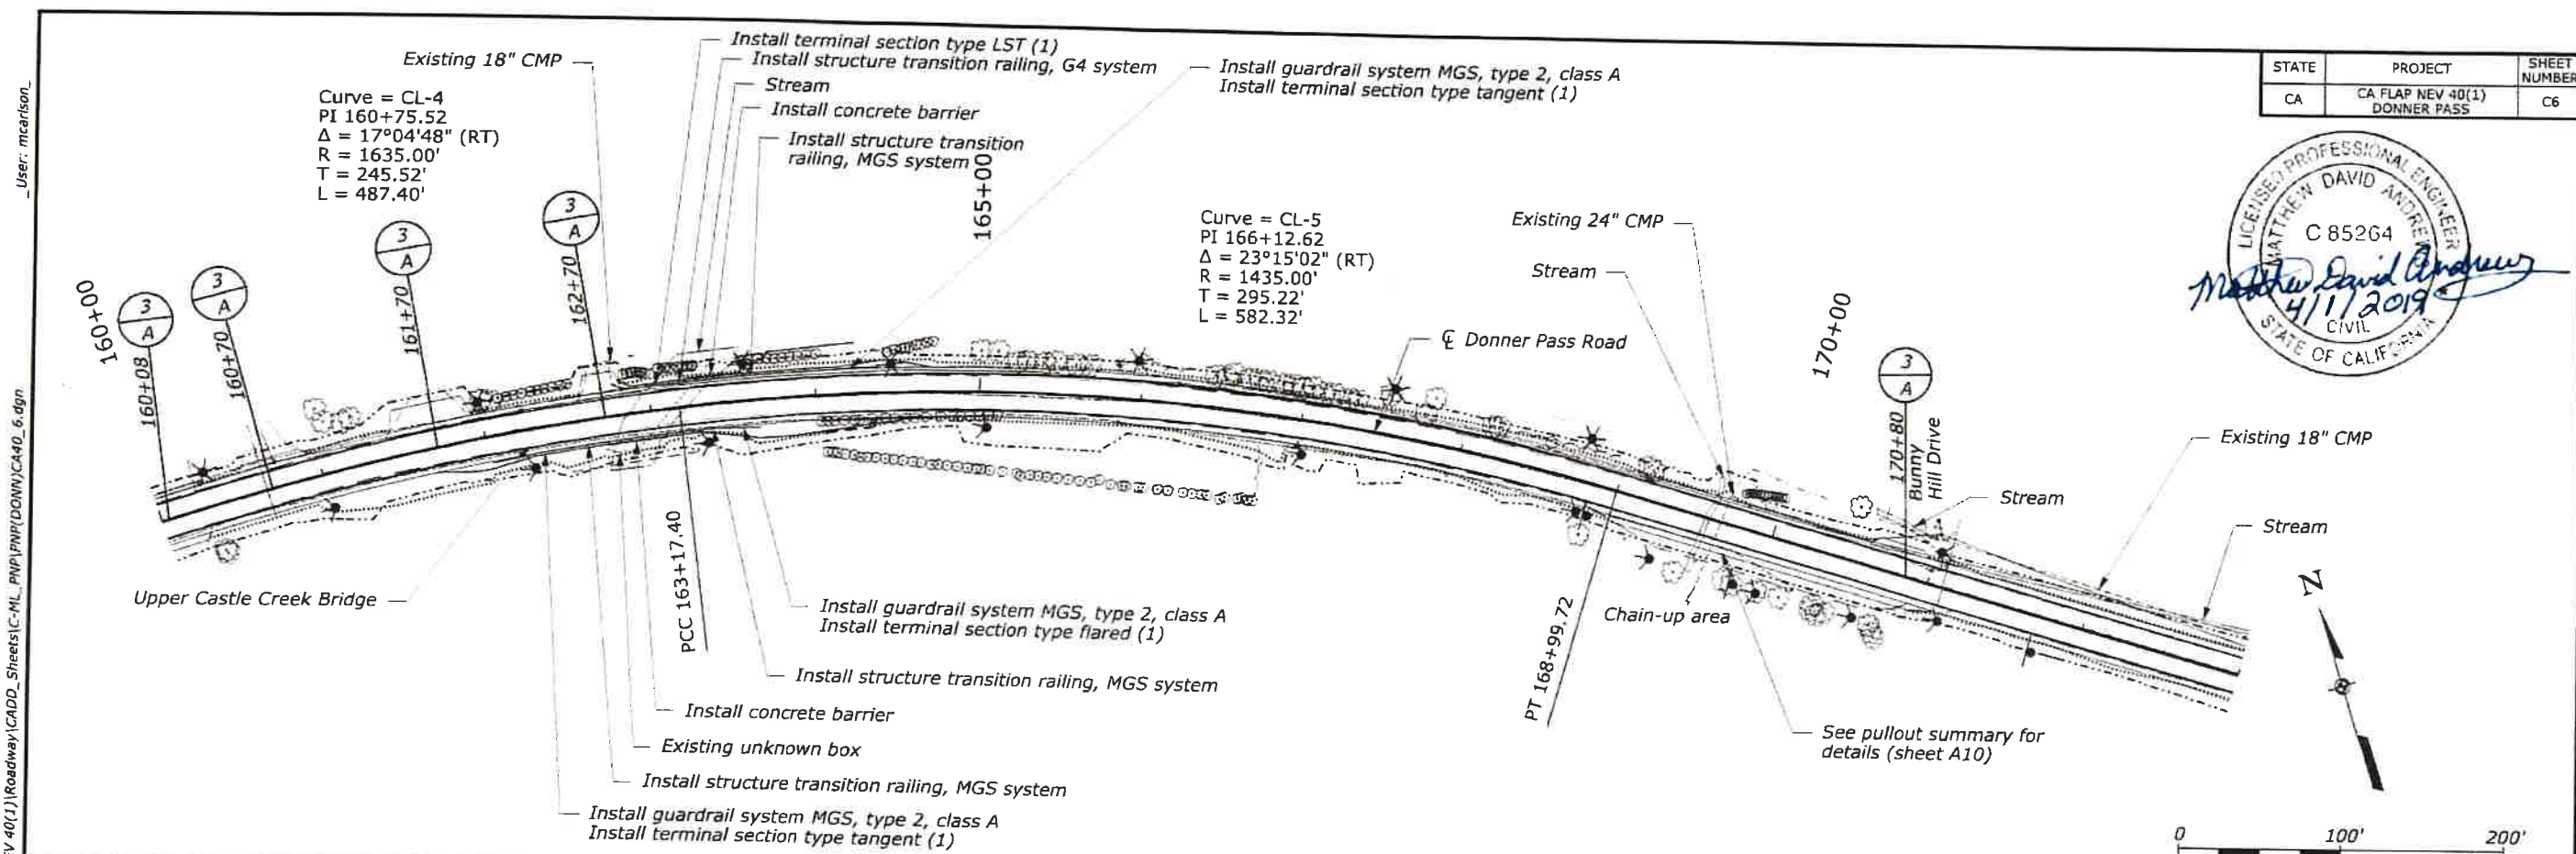

— User: dhrung

Q:\2015 Projects\15-030.02 Donner Pass Preliminary Design - C-ML-PNP\DONNER\CA40_5.dgn



8/3/2021

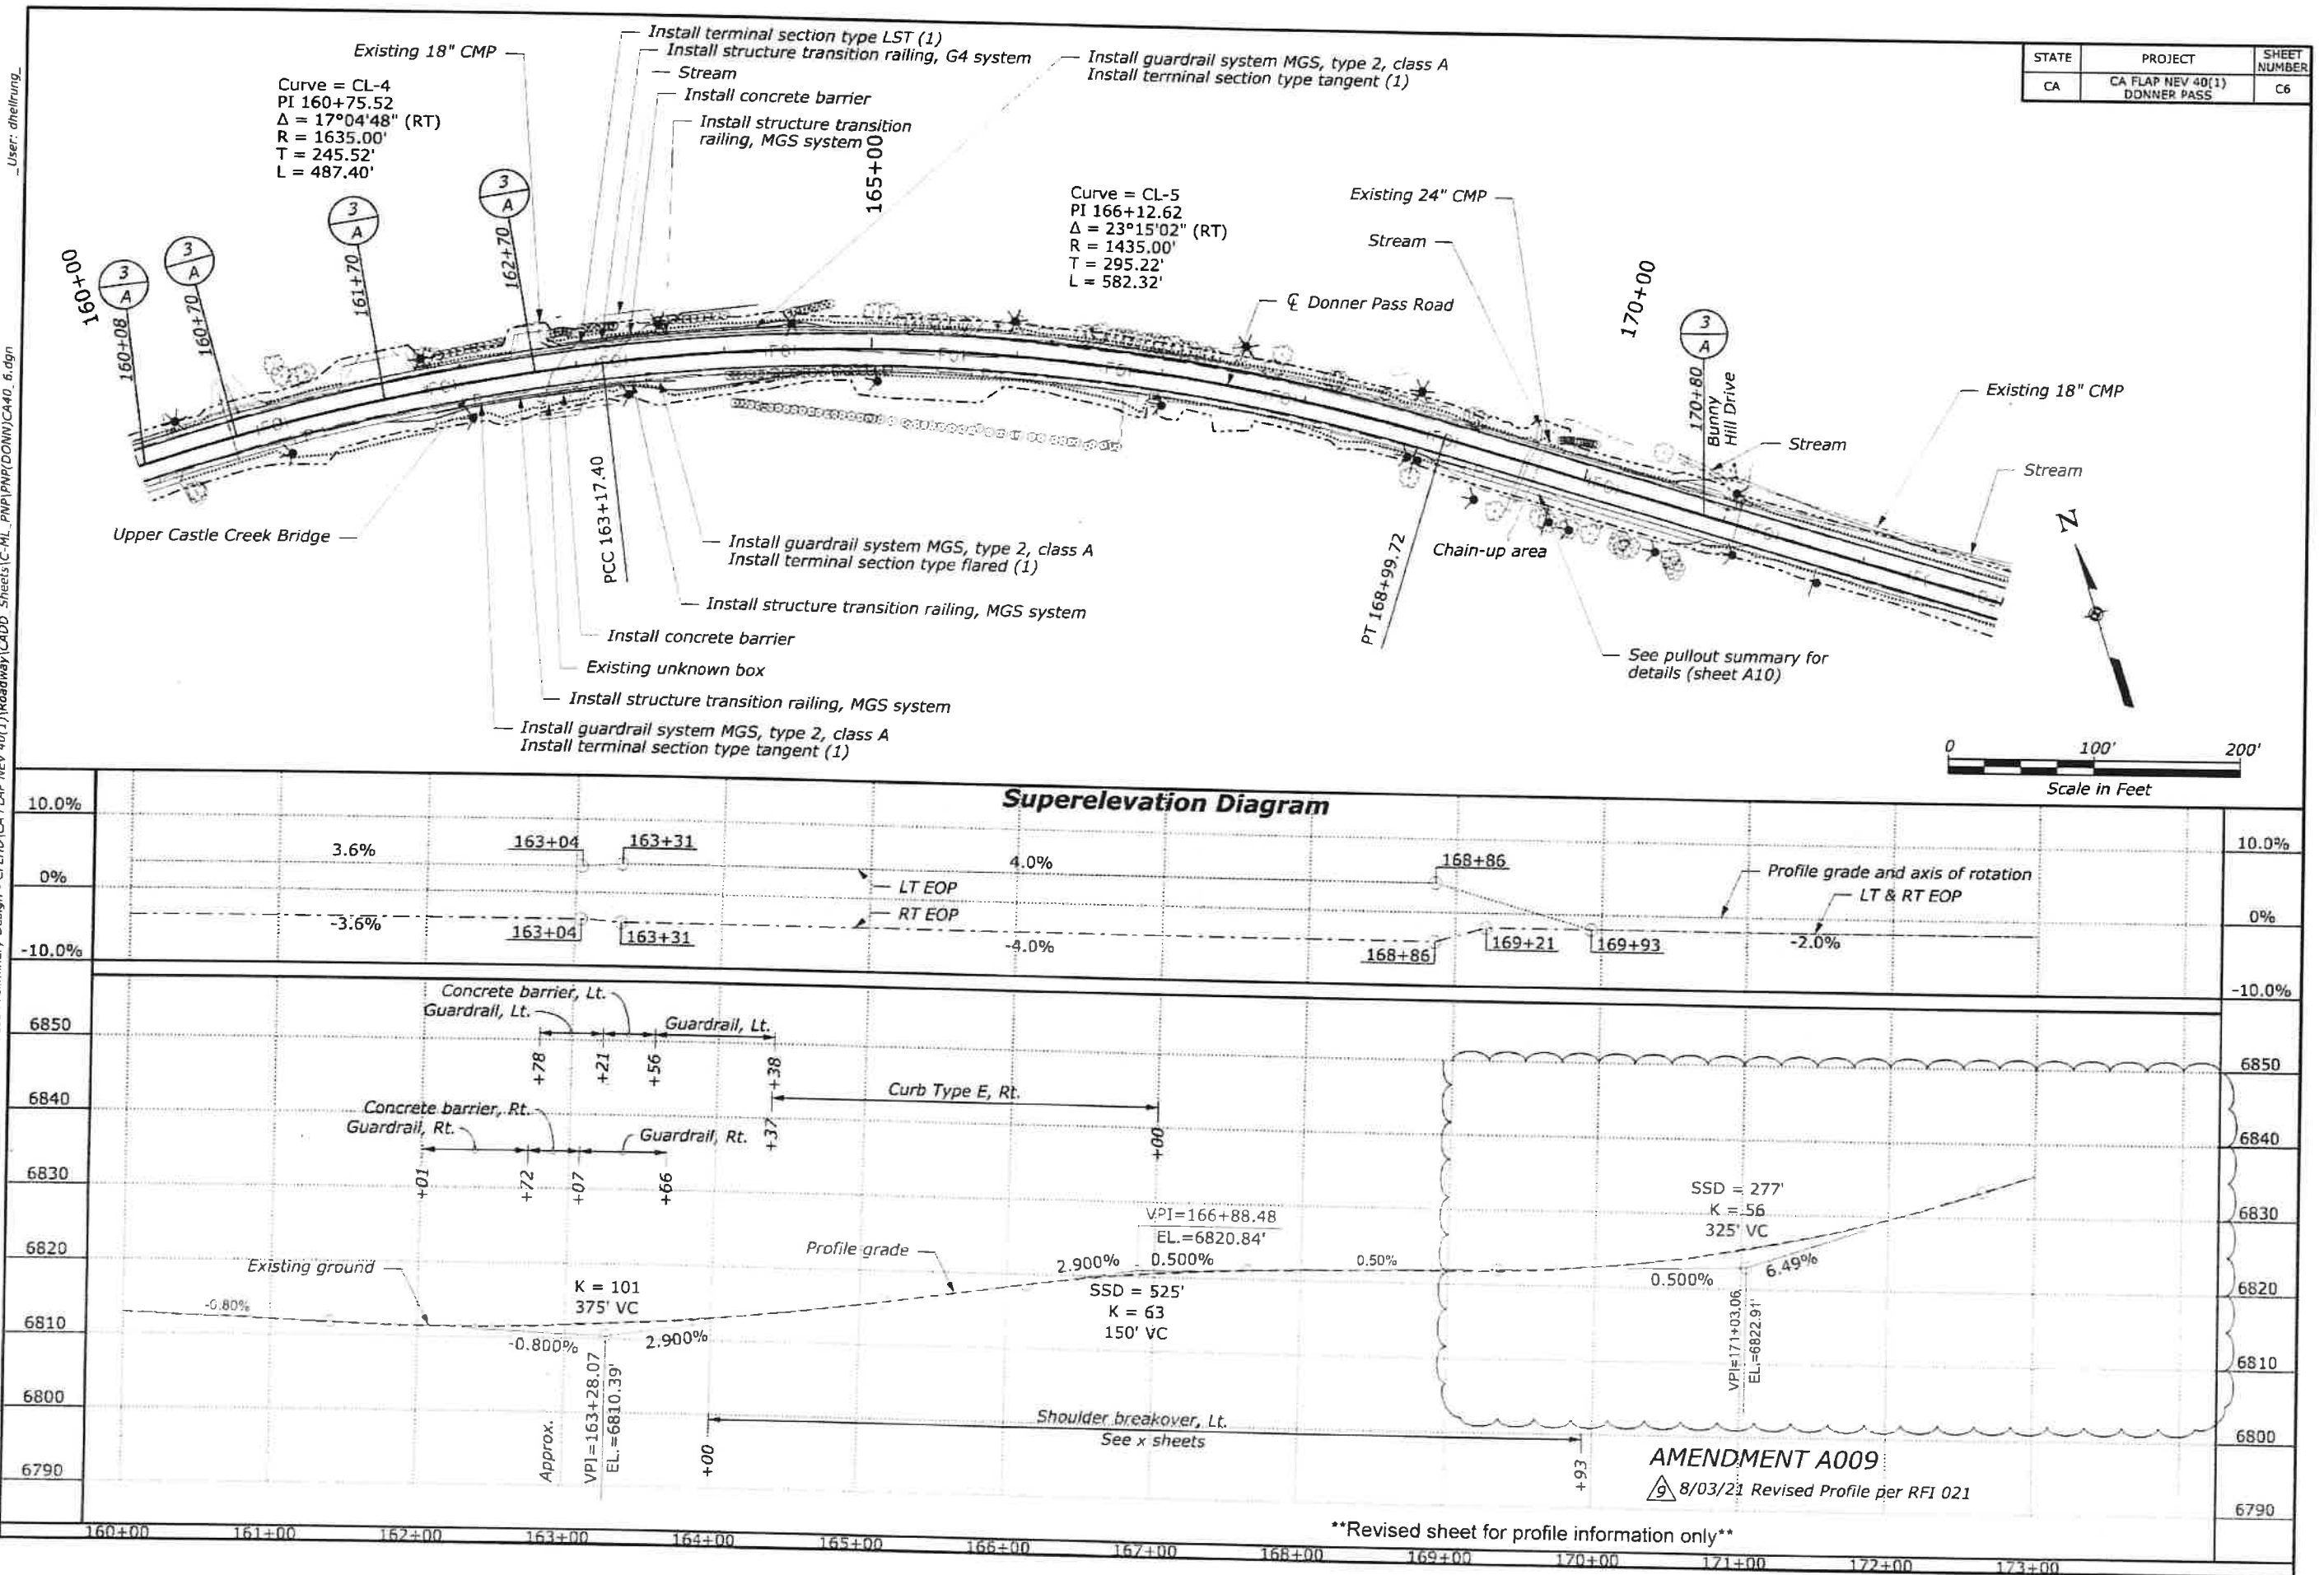


User: mcarlson

3/21/2019 7:18:52 AM Q:\2015 Projects\15-030.02 Donner Pass Preliminary Design - C:\HD\CA FLAP NEV 40(1)\Roadway\CADD_Sheets[C-M_L_PNP\PNP(DONN)]CA40_7.dgn

STATE	PROJECT	SHEET NUMBER
CA	CA FLAP NEV 40(1) DONNER PASS	C7

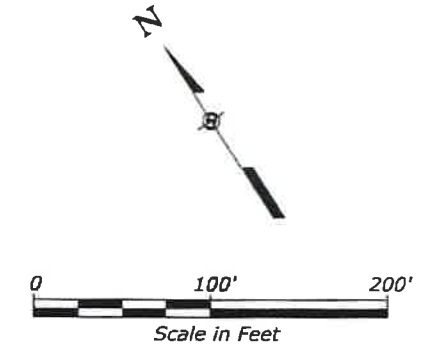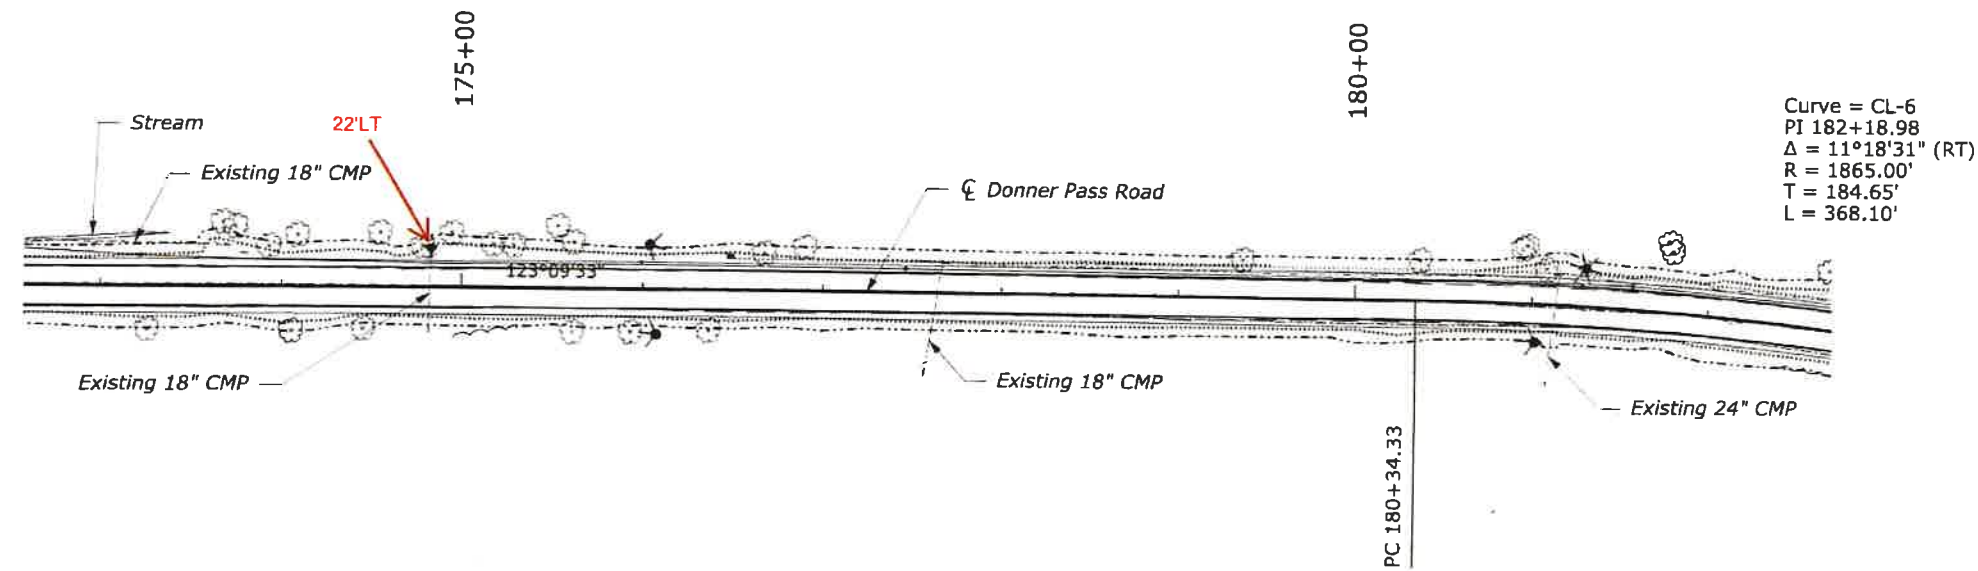


Superelevation Diagram


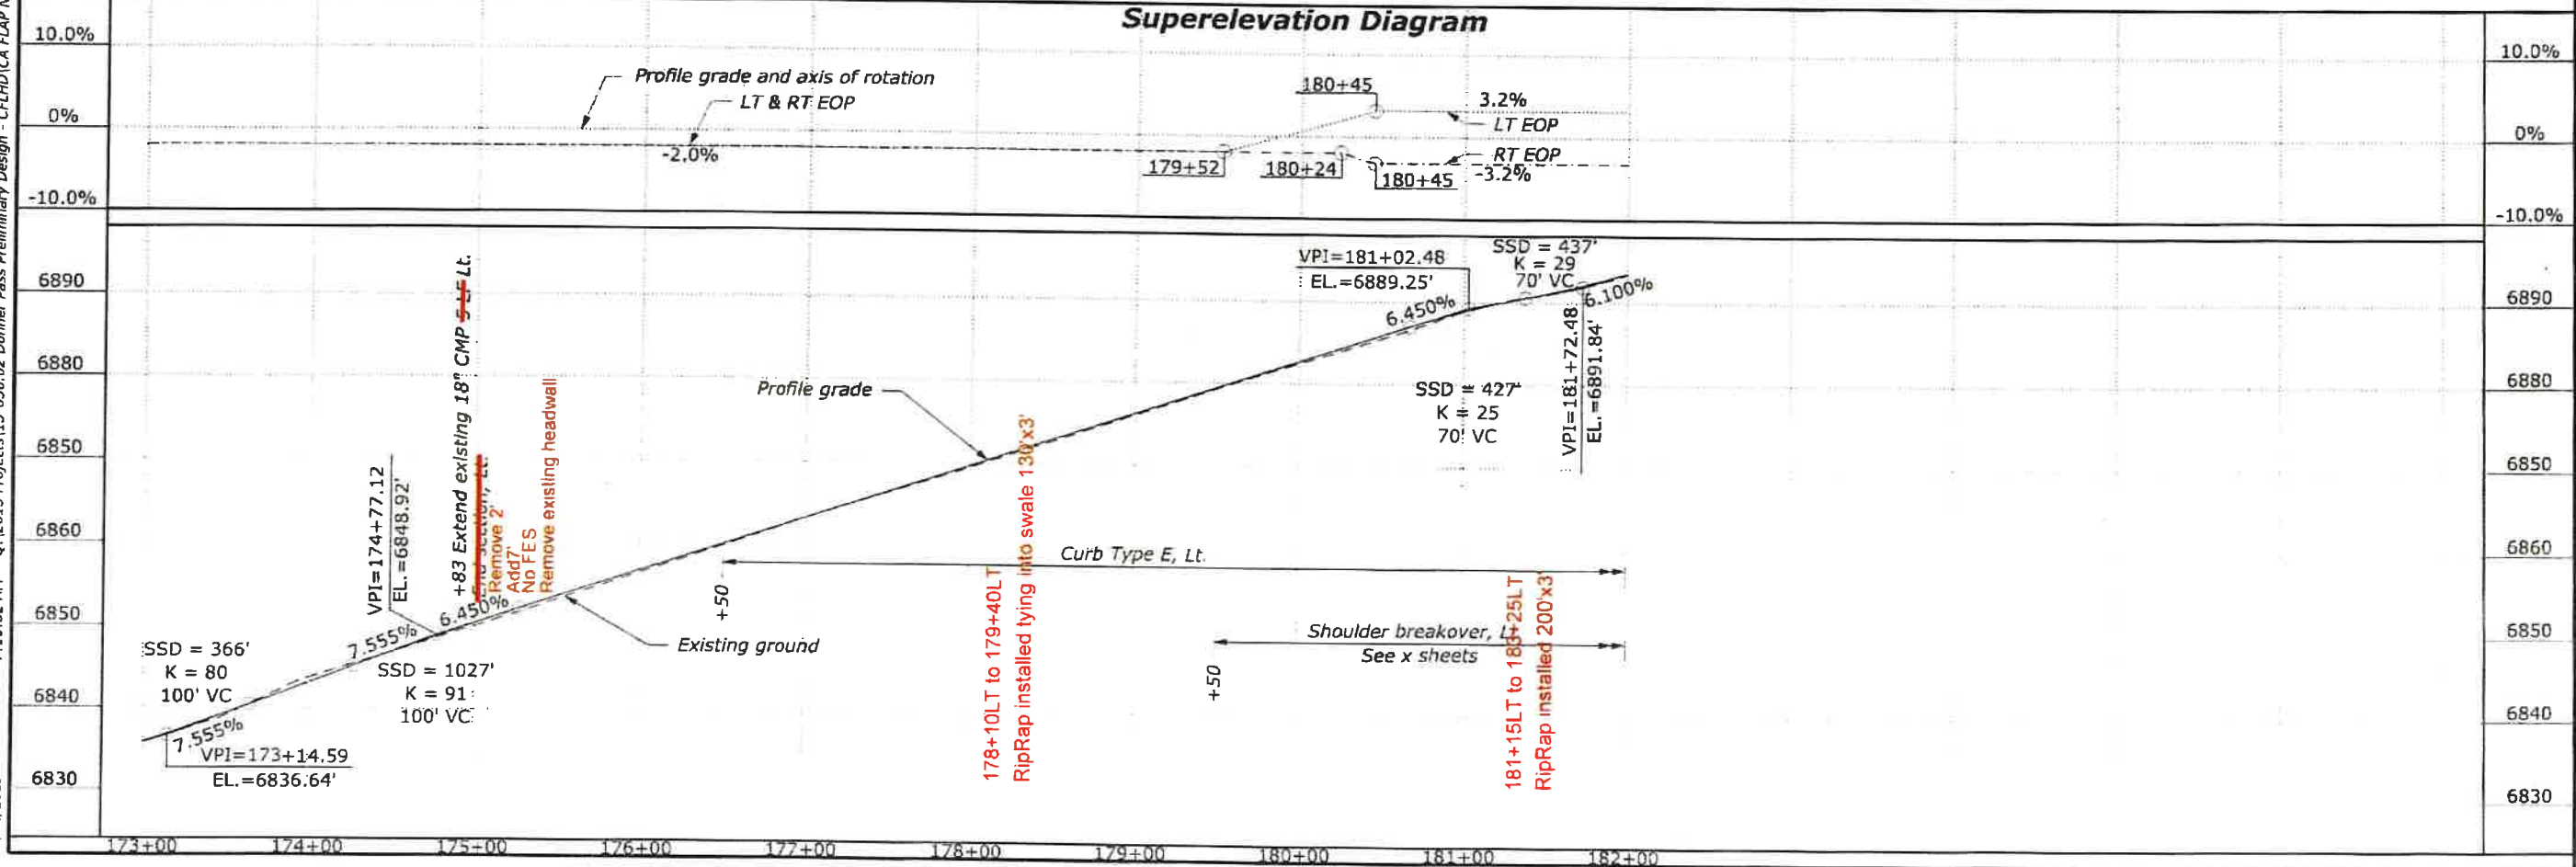


3/21/2019 7:18:52 AM Q:\2015 Projects\15-030.02 Donner Pass Preliminary Design - C-HD\CA FLAP NEV 40(1)\Roadway\CADD_Sheets\C-HL_PNP\PNP(DONN)\CA40_8.dgn User: mcarlson



STATE	PROJECT	SHEET NUMBER
CA	CA FLAP NEV 40(1) DONNER PASS	C8

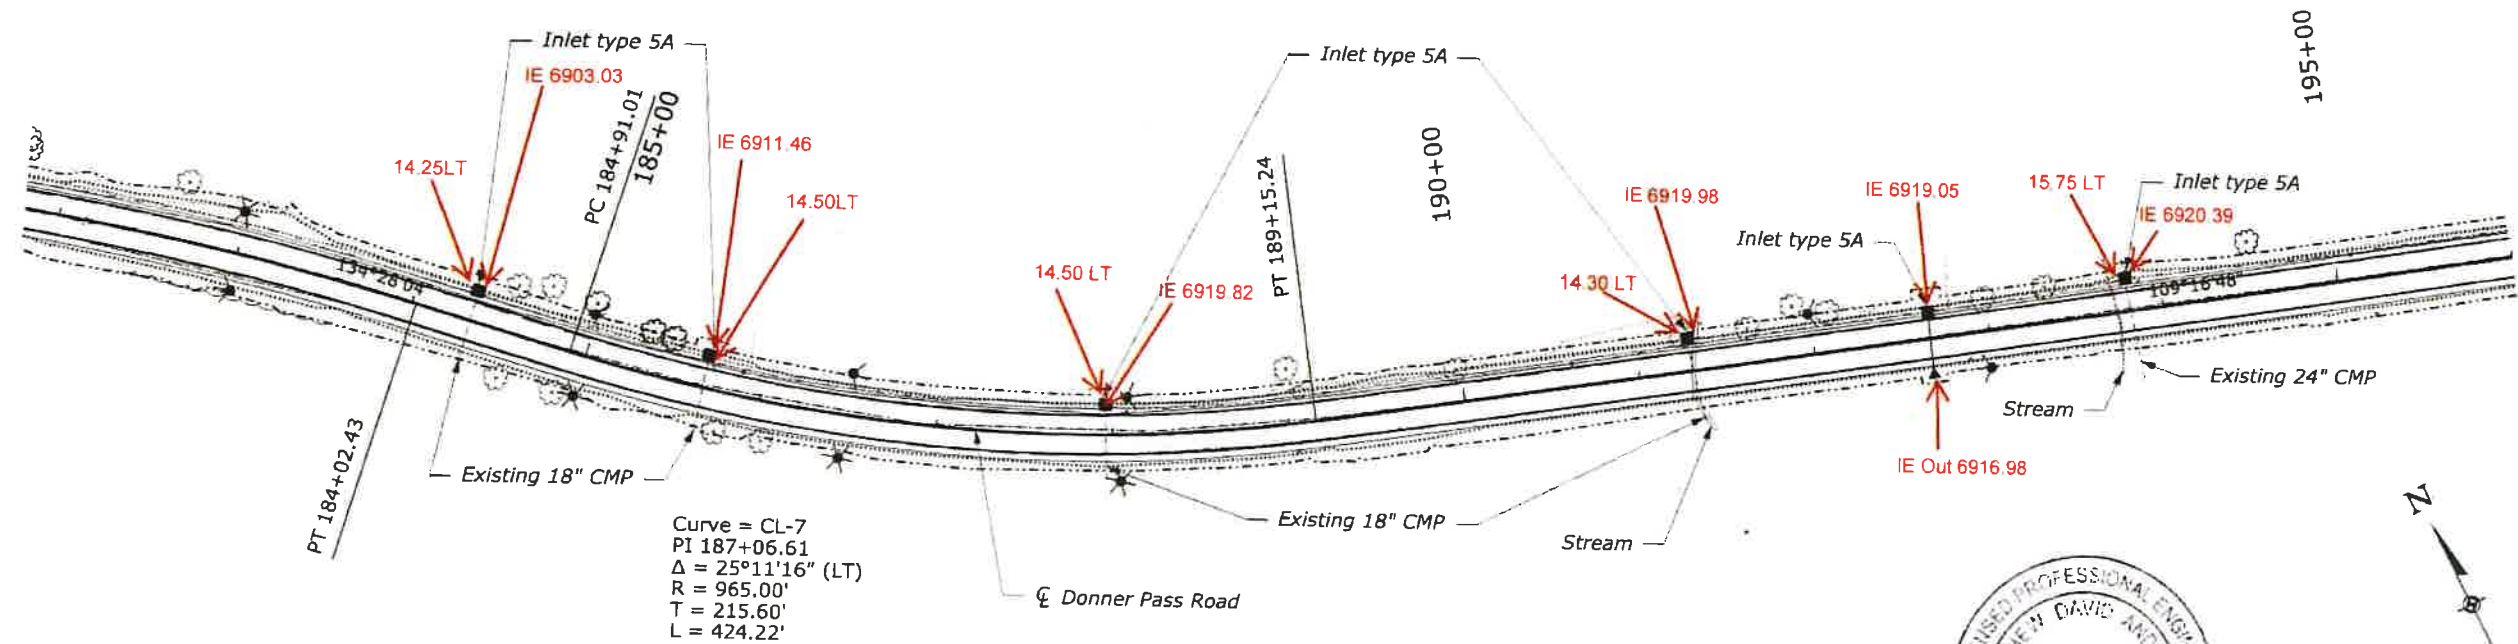



Superelevation Diagram

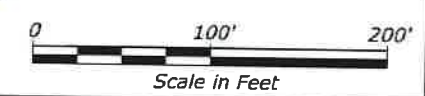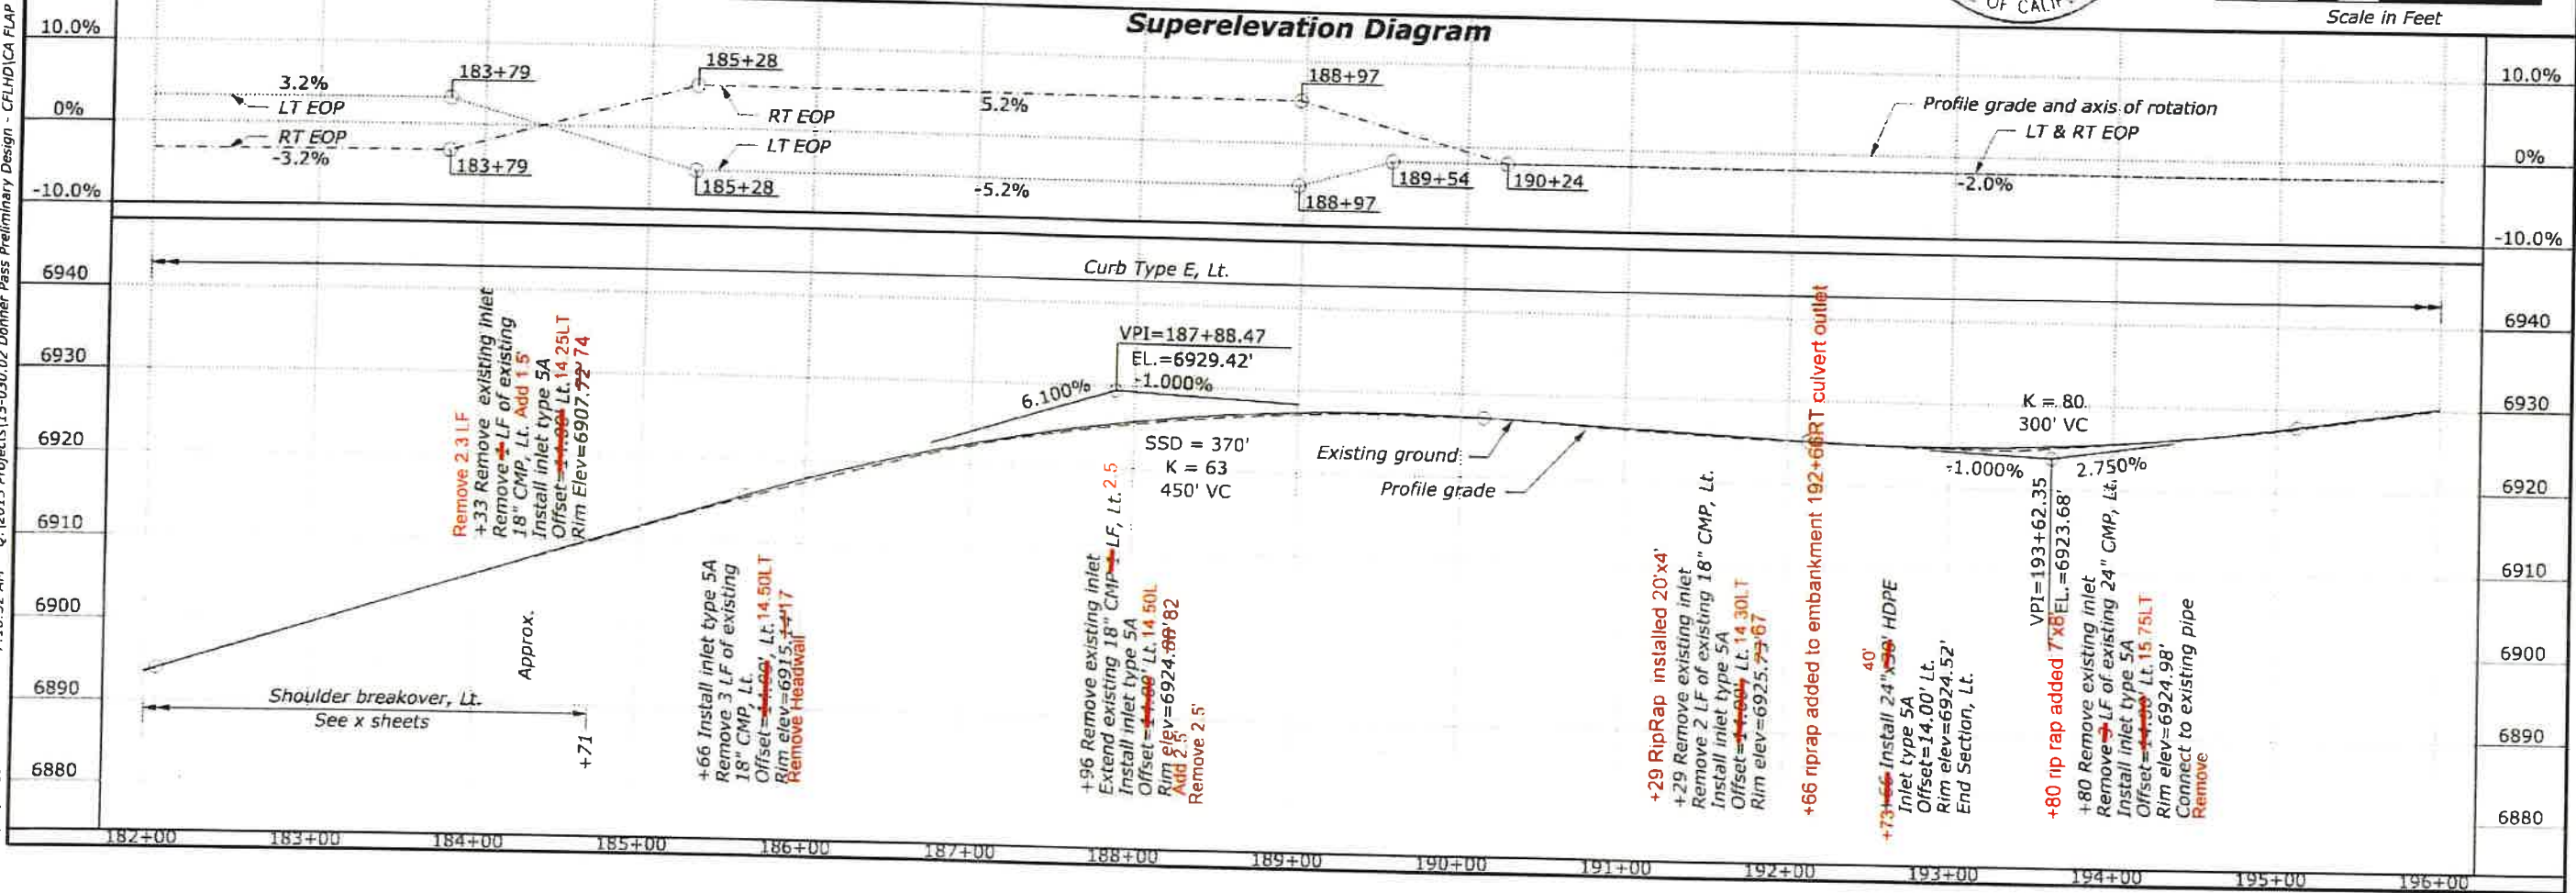

STATE	PROJECT	SHEET NUMBER
CA	CA FLAP NEV 40(1) DONNER PASS	C8

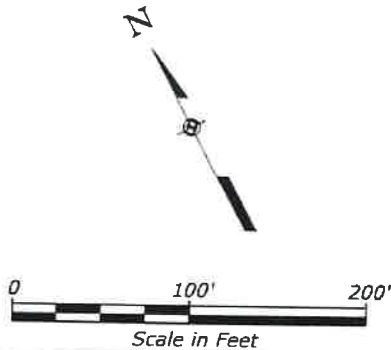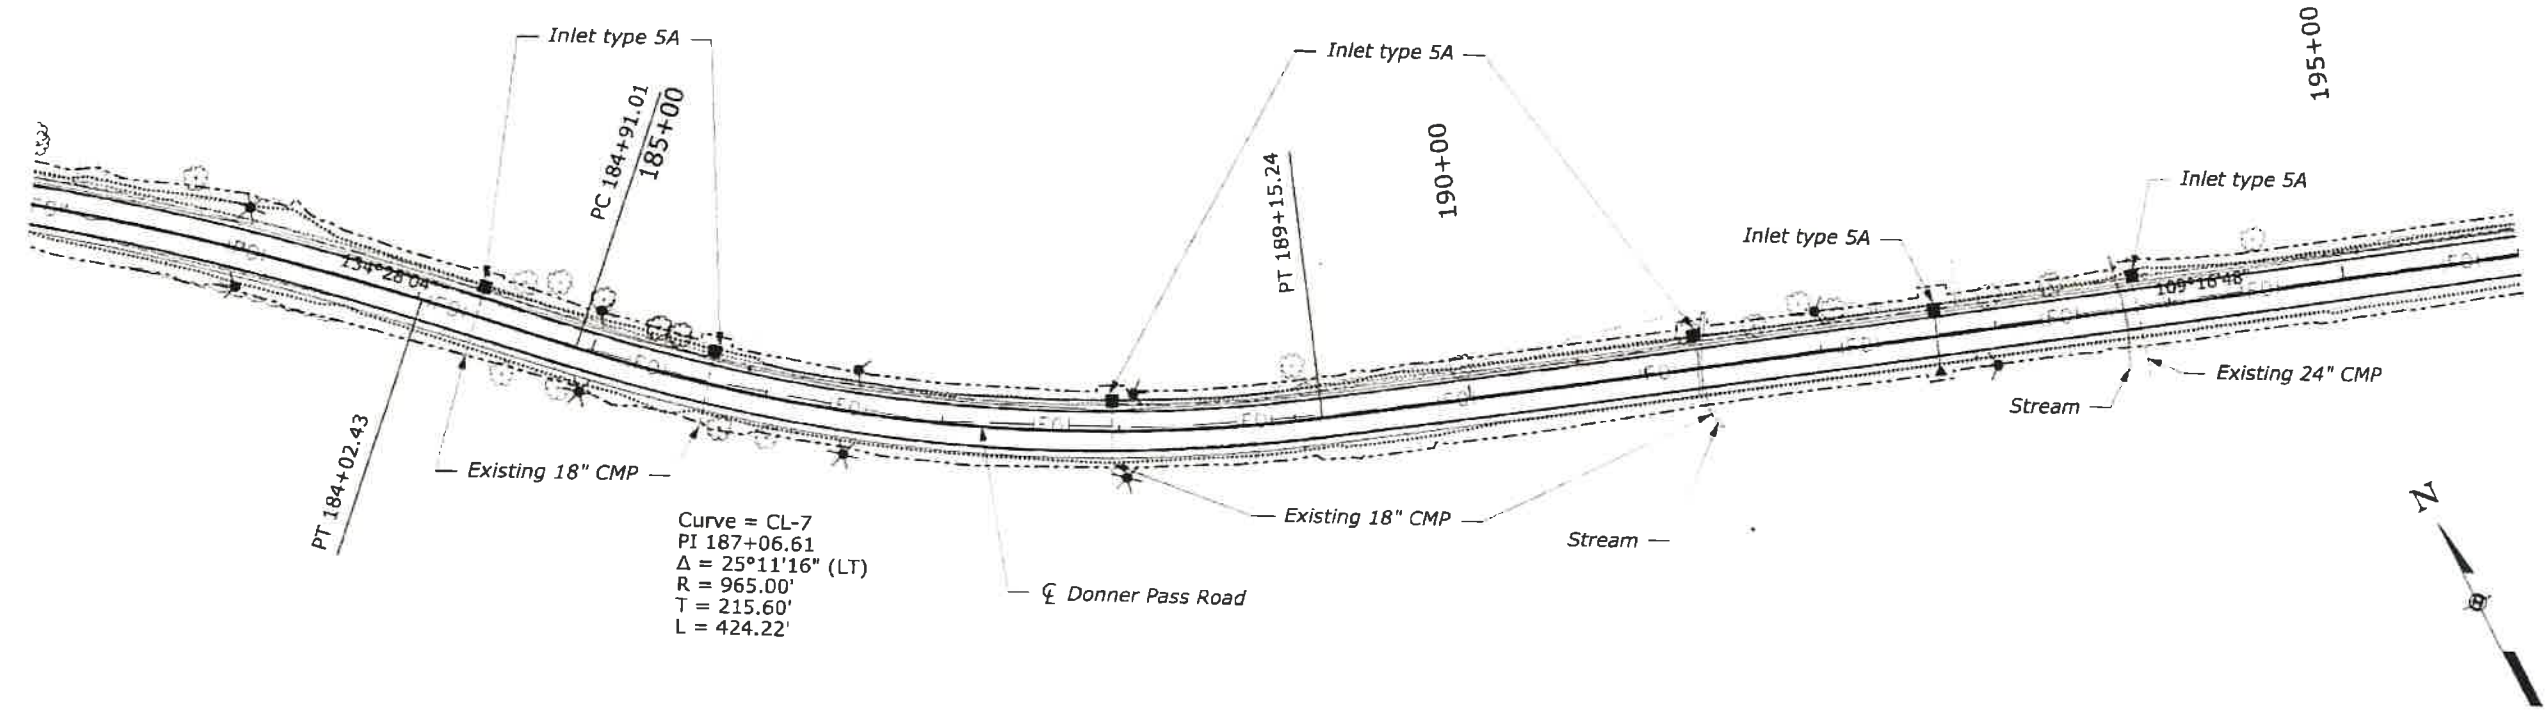

Superelevation Diagram

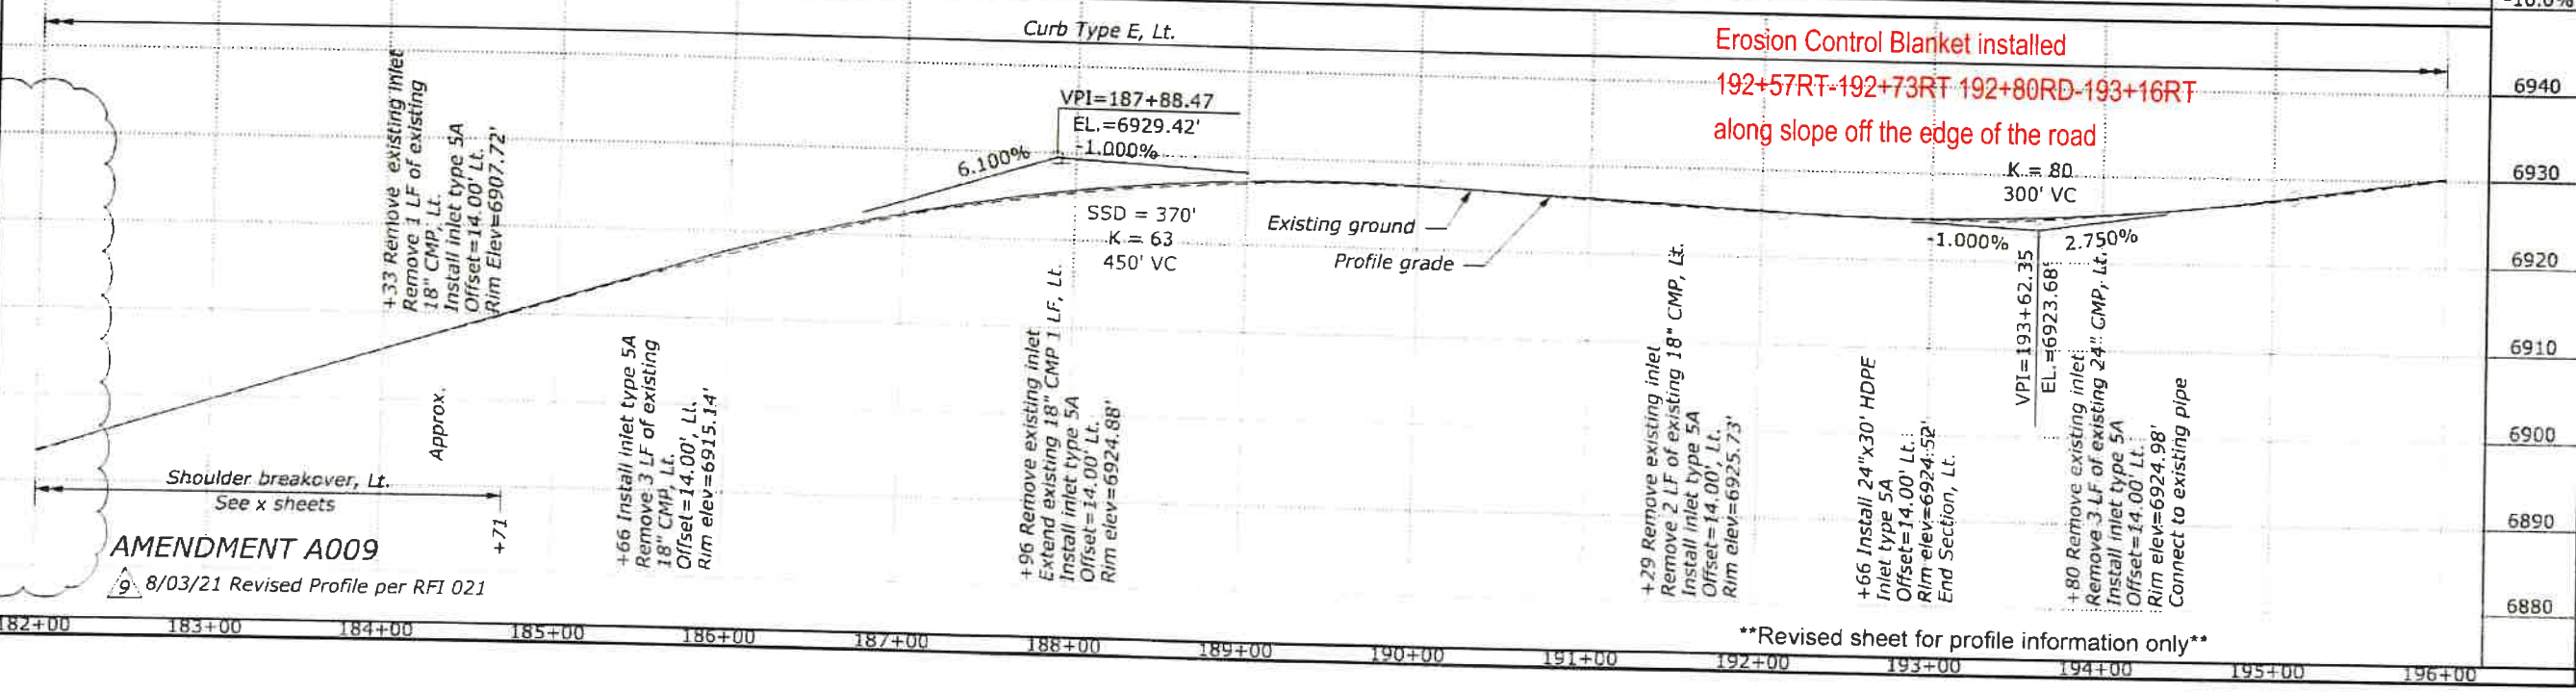
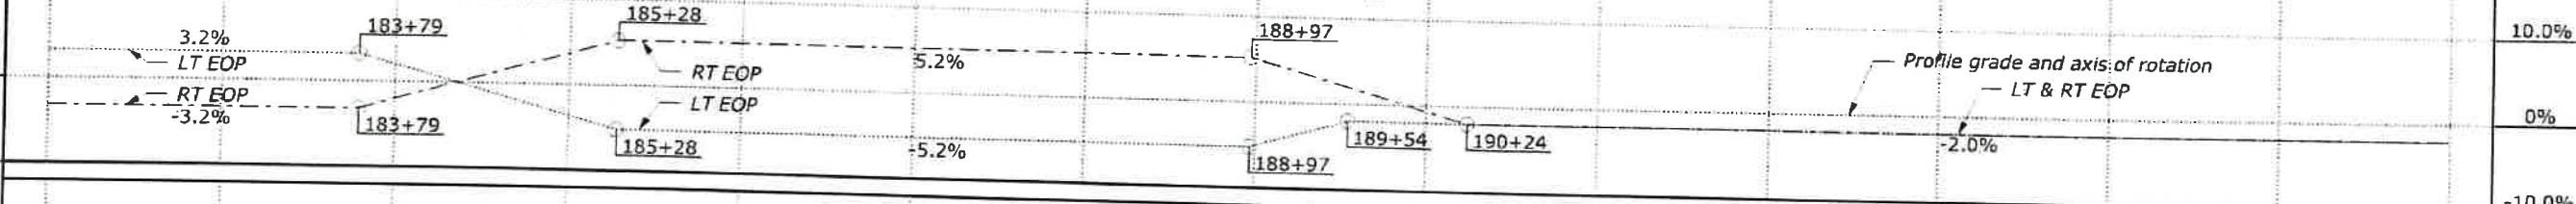


Revised sheet for profile information only

STATE	PROJECT	SHEET NUMBER
CA	CA FLAP NEV 40(1) DONNER PASS	C9

User: mearlson


4/1/2019 12:01:52 PM Q:\2015 Projects\15-030.02 Donner Pass Preliminary Design - CFLHD\CA FLAP NEV 40(1)\Roadway\CADD_Sheets\C-M_L_PWP\PNP\DONN\CA40_9.dgn

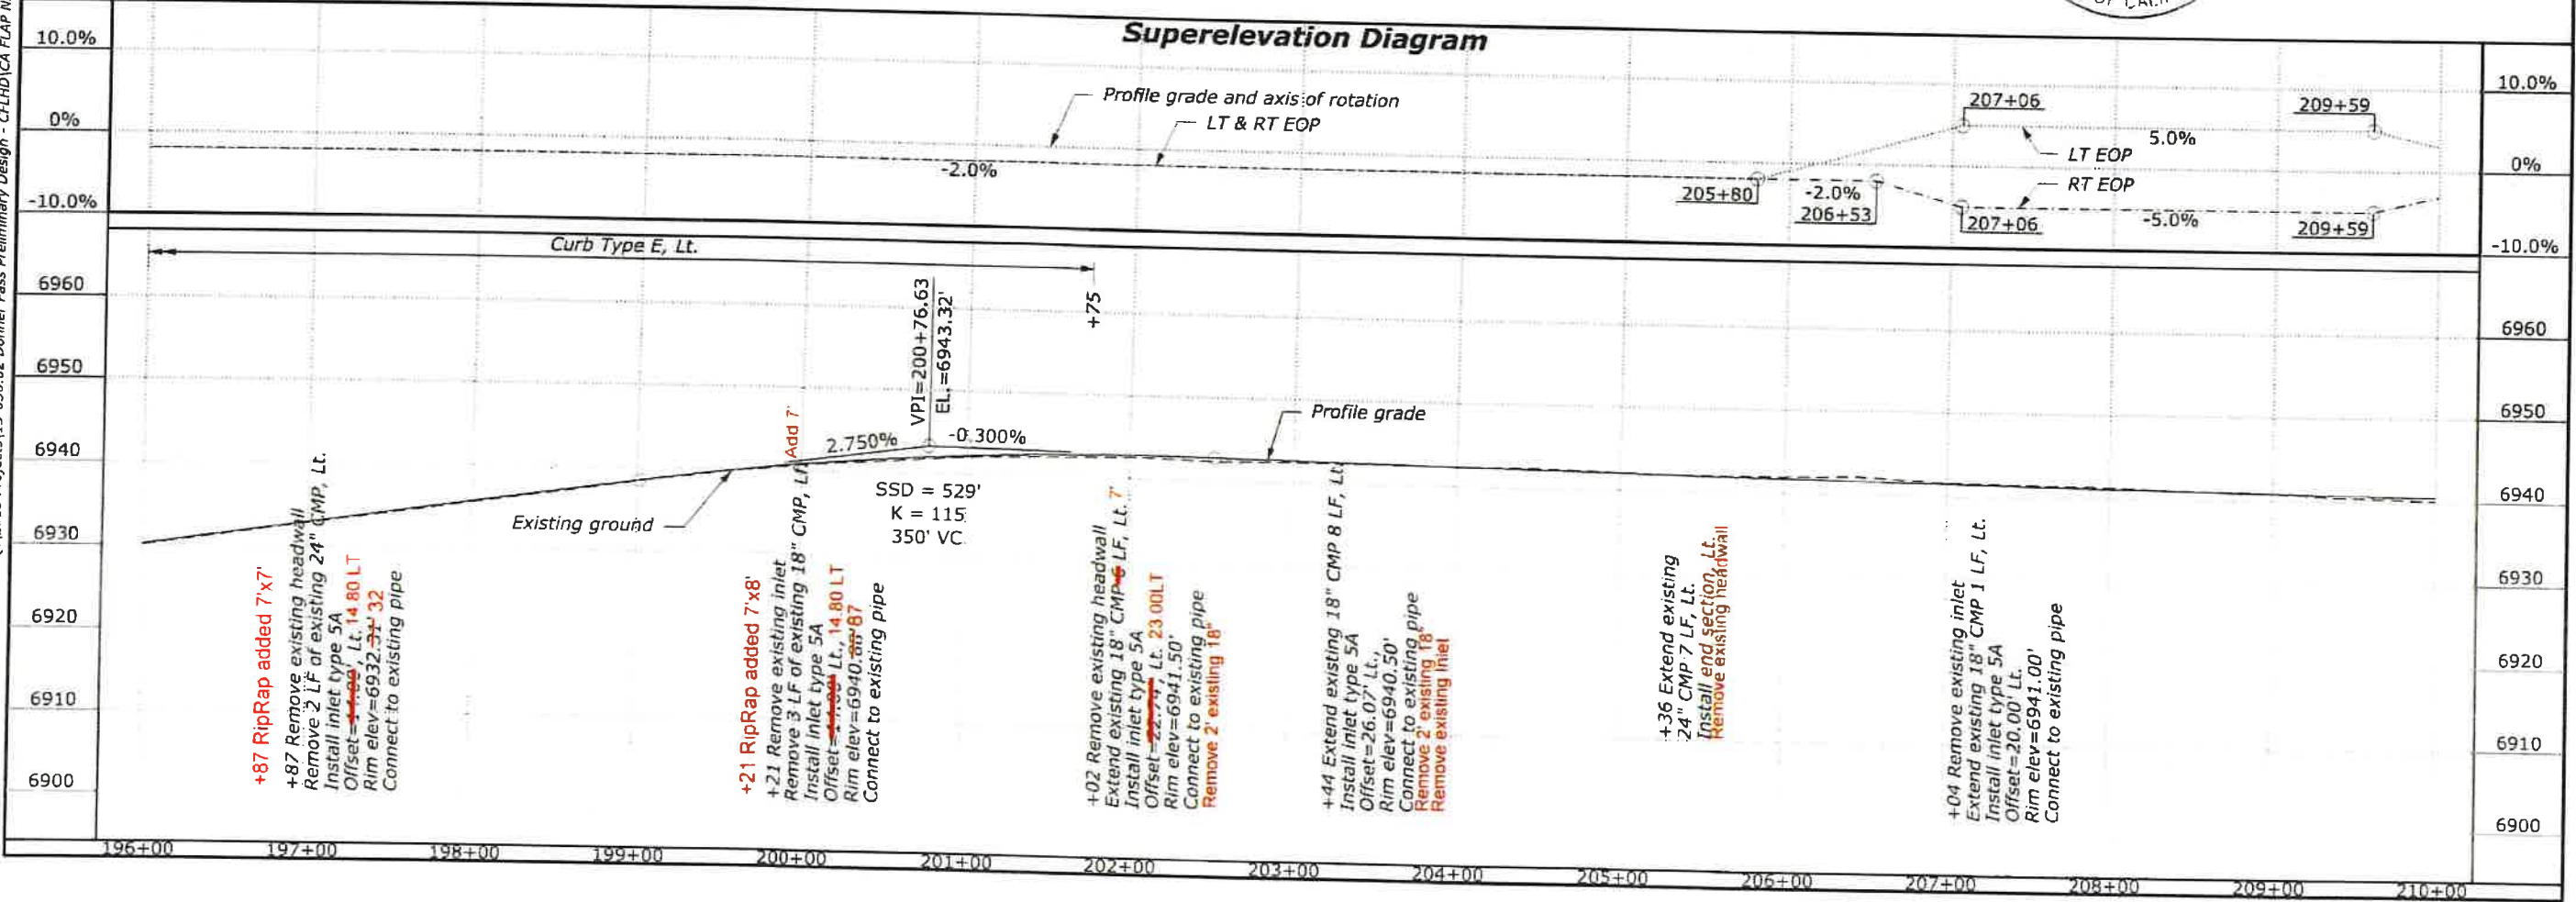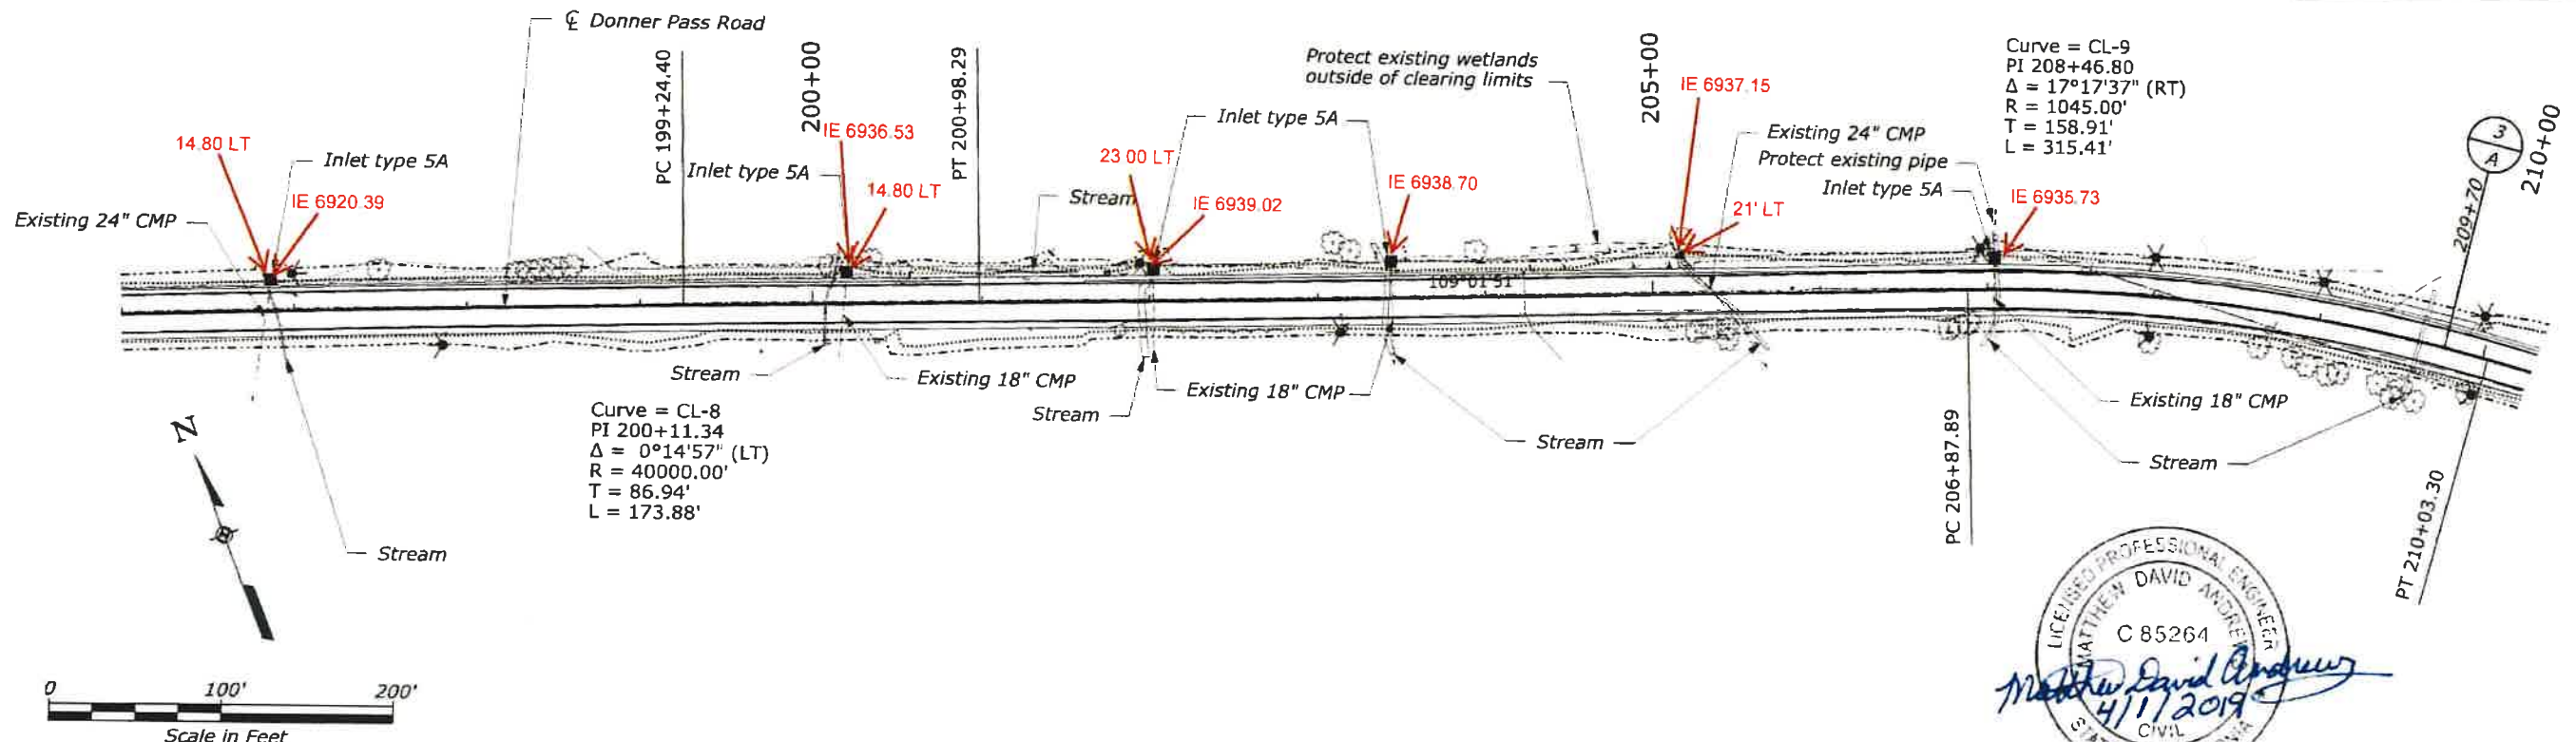


3/21/2019 7:18:53 AM Q:\2015 Projects\15-030.02 Donner Pass Preliminary Design - CFLHD\CA FLAP NEV 40(1)\Roadway\CADD_Sheets\C-ML_PNP\PNP\DONN\CA40_10.dgn User: mcarlson

STATE	PROJECT	SHEET NUMBER
CA	CA FLAP NEV 40(1) DONNER PASS	C10

Curve = CL-11
PI 222+81.18
 $\Delta = 33^\circ 03' 08''$ (RT)
R = 985.00'
T = 292.26'
L = 568.22'

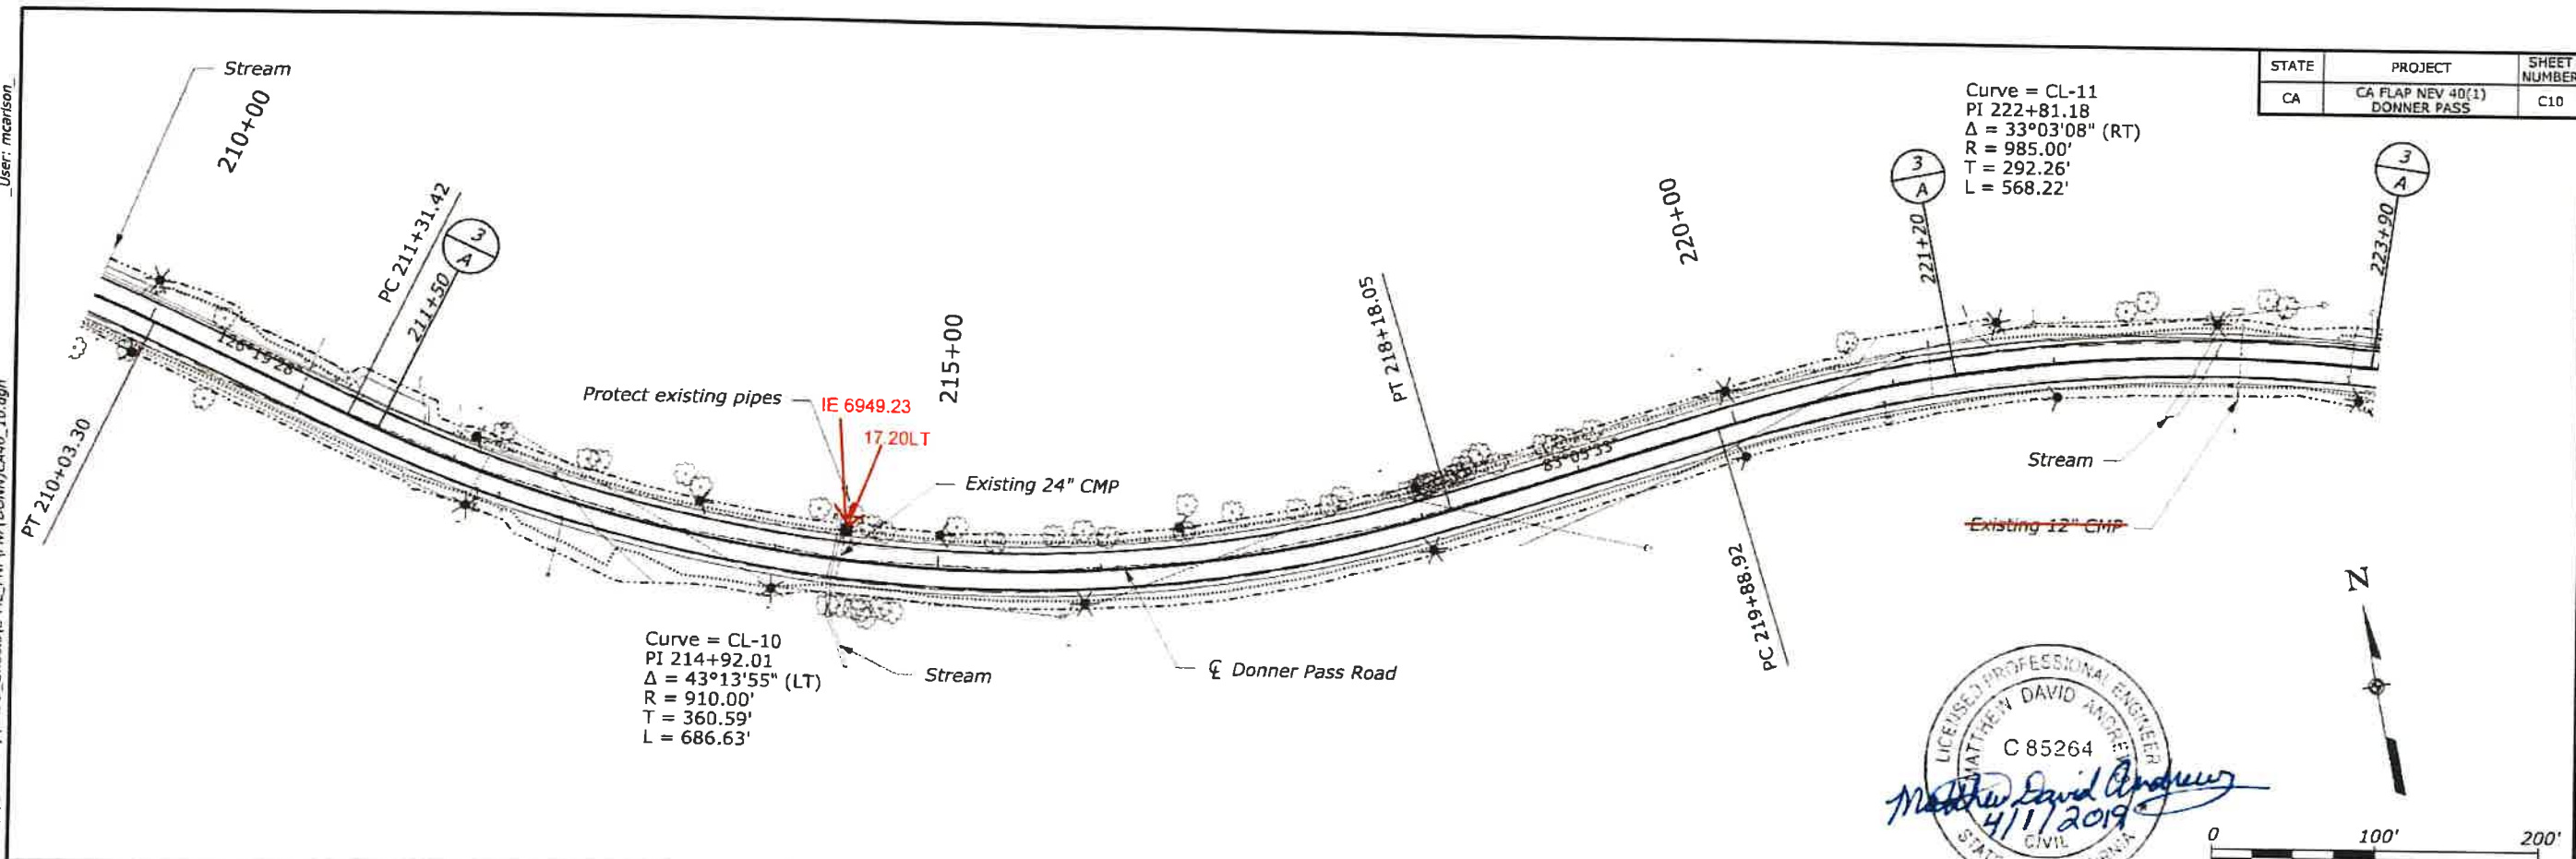



Superelevation Diagram

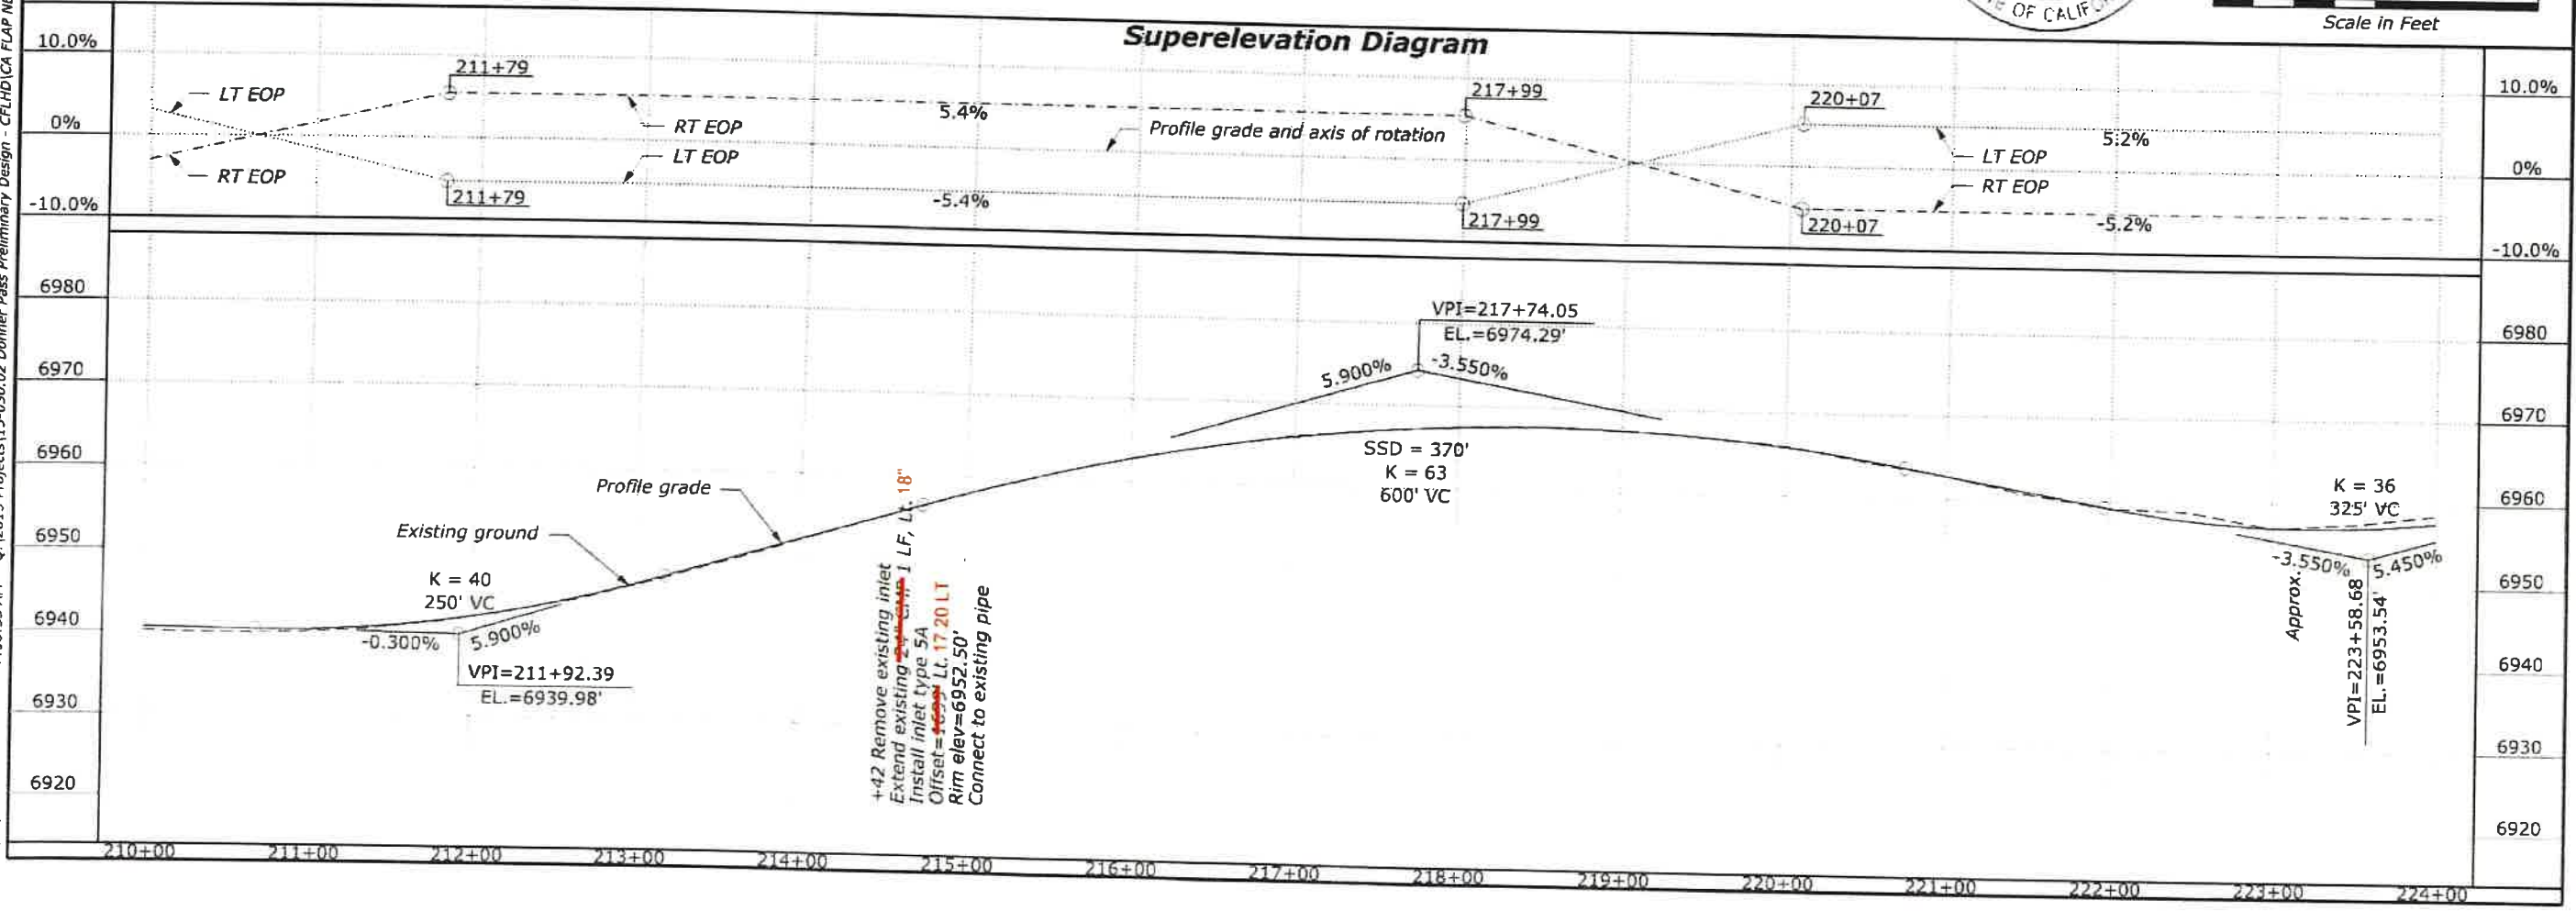

7/27/2021 8:48:22 AM Q:\2015 Projects\15-030.02 Donner Pass Preliminary Design - CELHO\CA FLAP NEV 40(J)\Roadway\CADD_Sheets\C-M_L_PNP\PNP(DOWN)\CA10_10.dgn User: dshelling


STATE	PROJECT	SHEET NUMBER
CA	CA FLAP NEV 40(1) DONNER PASS	C10

Curve = CL-11
PI 222+81.18
 $\Delta = 33^\circ 03' 08''$ (RT)
R = 985.00'
T = 292.26'
L = 568.22'

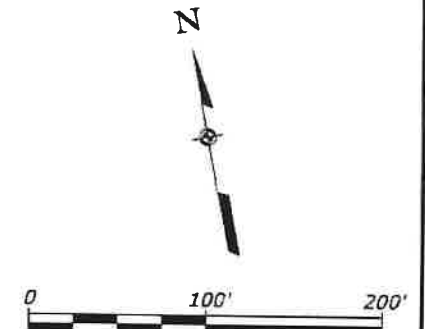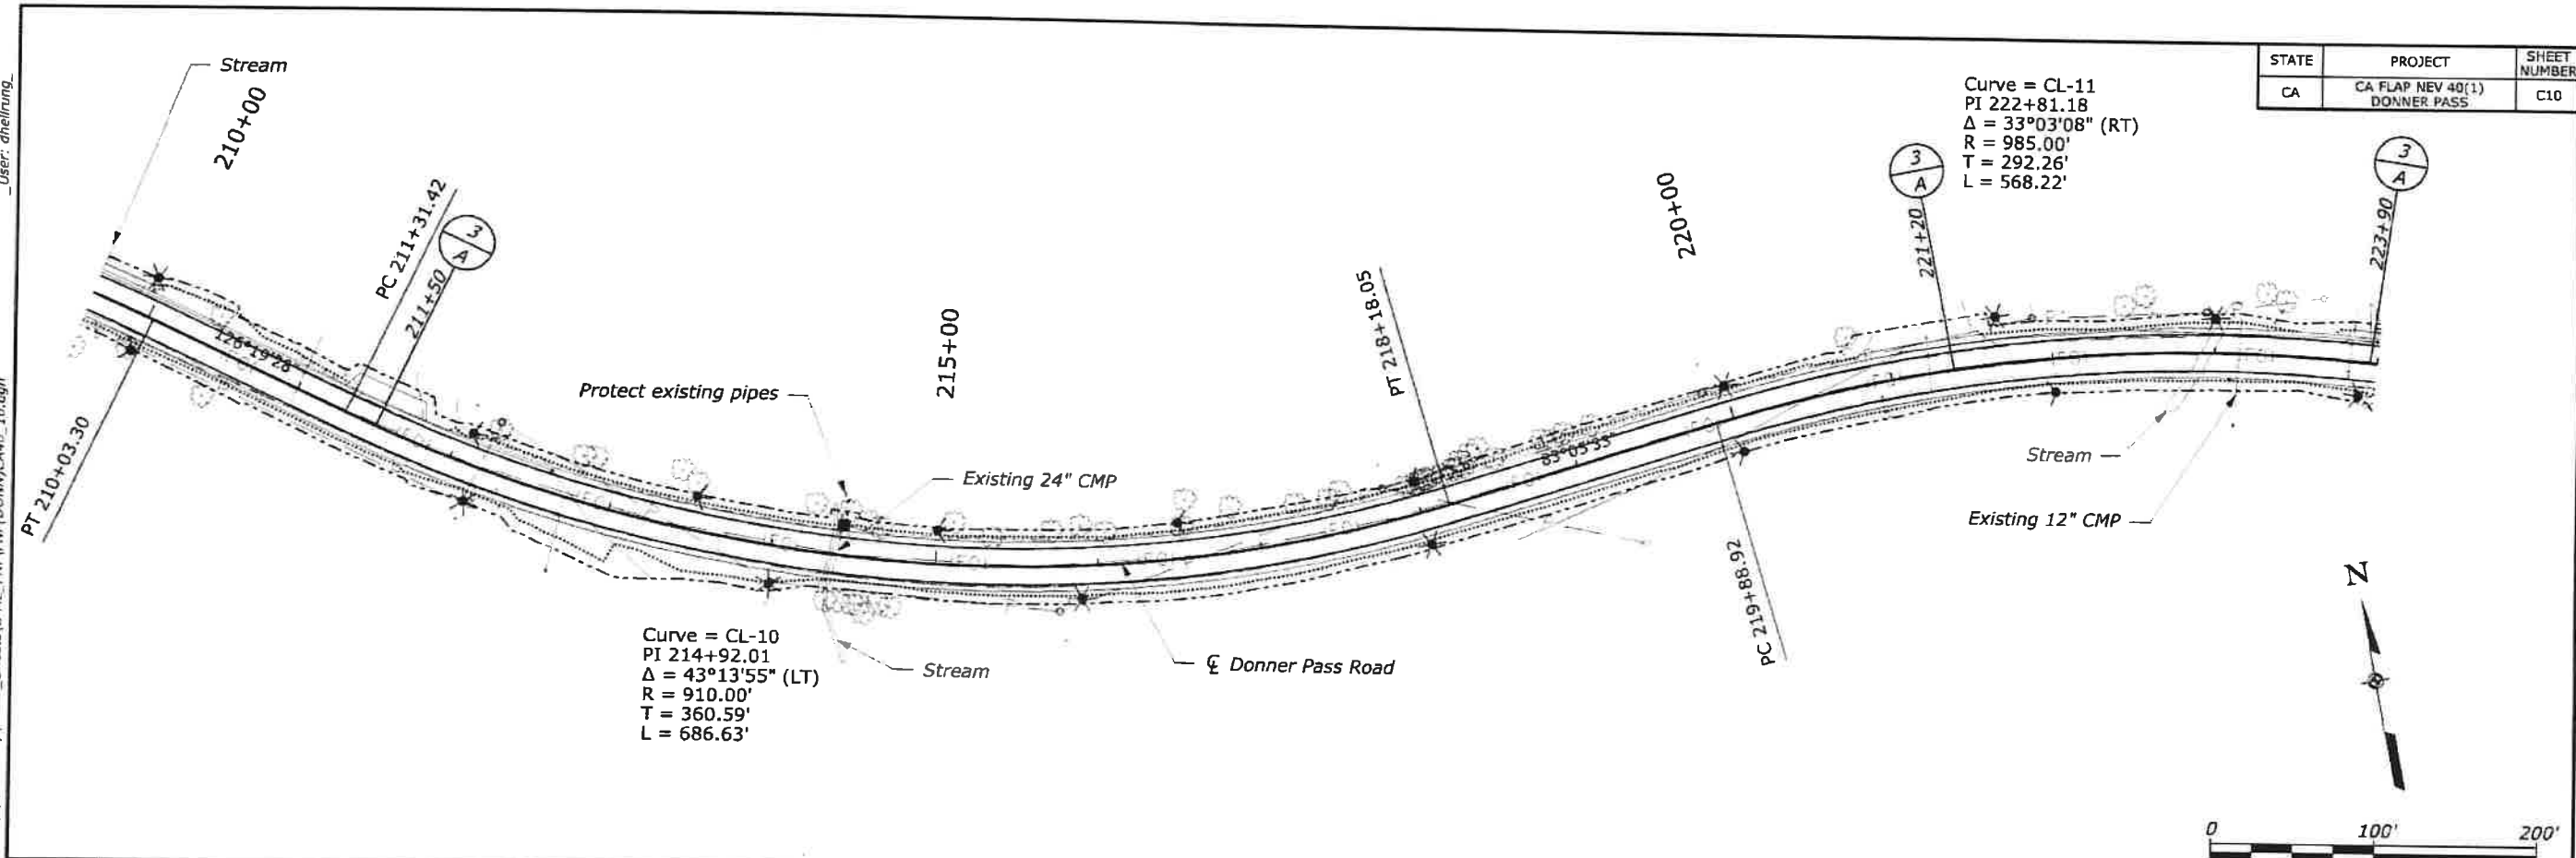

Superelevation Diagram

Revised sheet for profile information only Scale in Feet

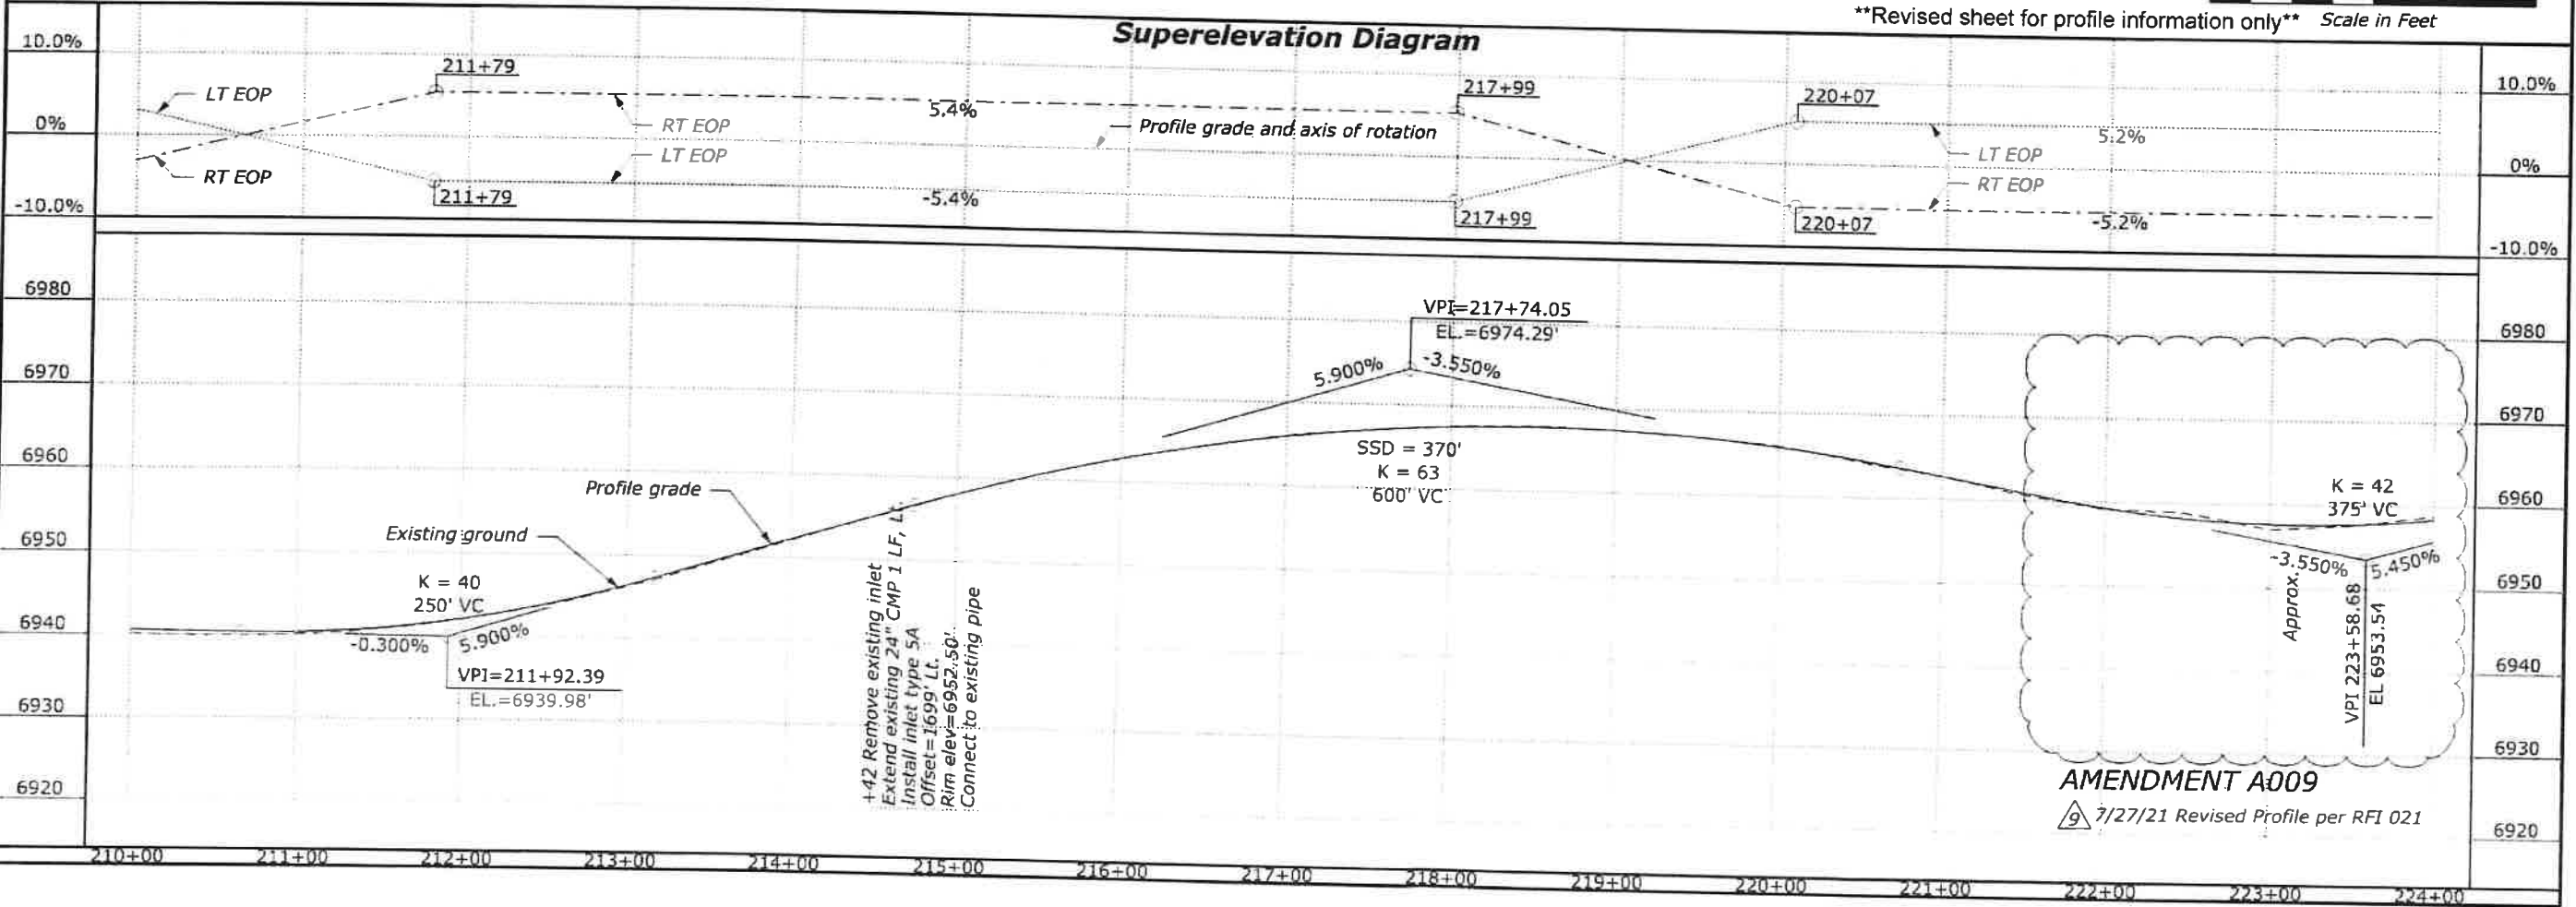

AMENDMENT A009

7/27/21 Revised Profile per RFI 021

